


Baltimore Commons


7465 Candlewood Road
Suites Q-Y
Hanover, MD 21076

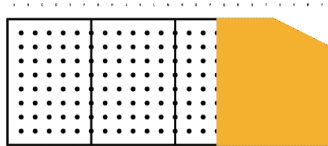

Building Key Plan

Total SF Available - 61,200 SF

Office - 4,353 SF
Warehouse - 56,847 SF

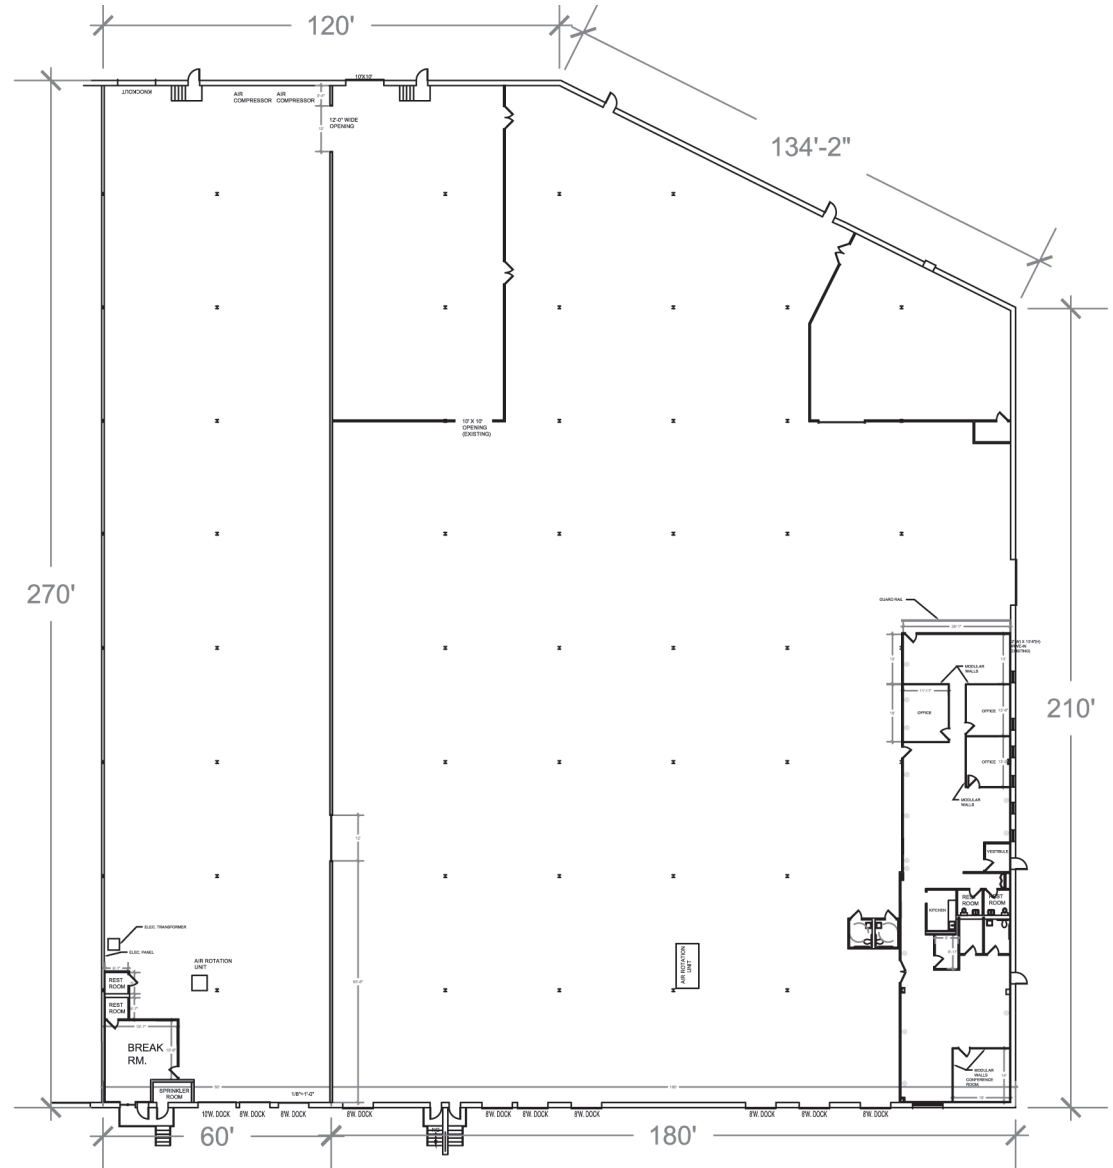


Plan not to scale - this is not a construction document.

Baltimore Commons

7465 Candlewood Road
Suites Q-Y (Office)
Hanover, MD 21076

Total SF Office Available
4,353 RSF

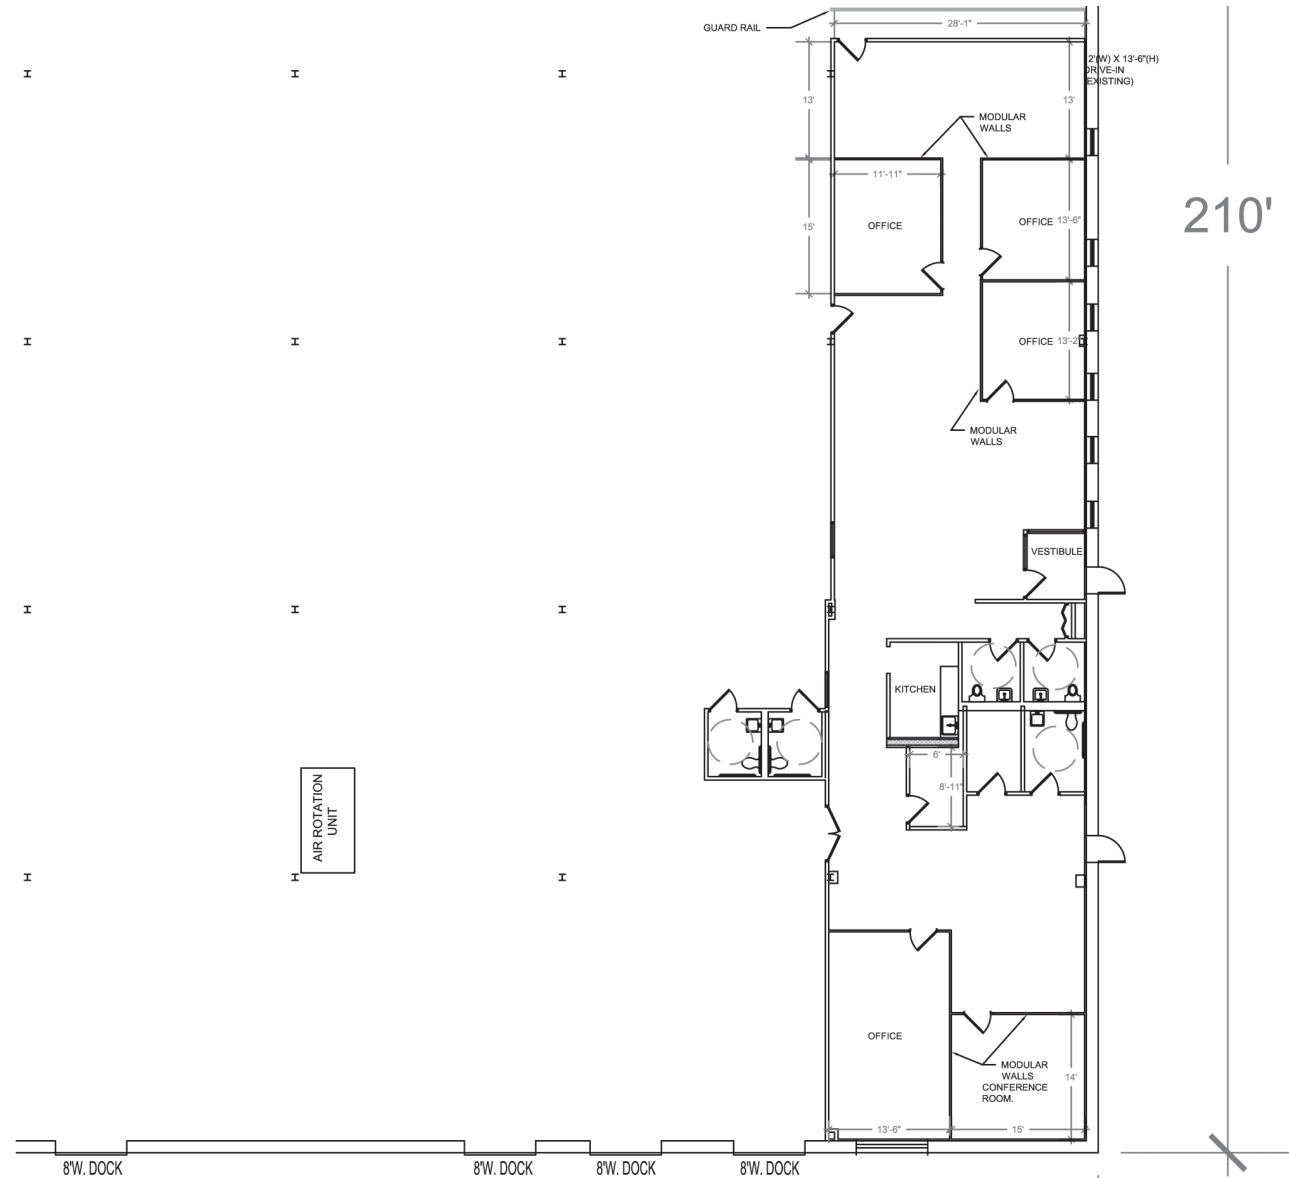

Plan not to scale - this is not a construction document.