

Nursery



719 Hammonds Ferry Road
Suites A-S
Linthicum, MD 21090

Total SF Available - 101,500 SF

Office - 15,150 SF
Warehouse - 86,350 SF



Building Key Plan

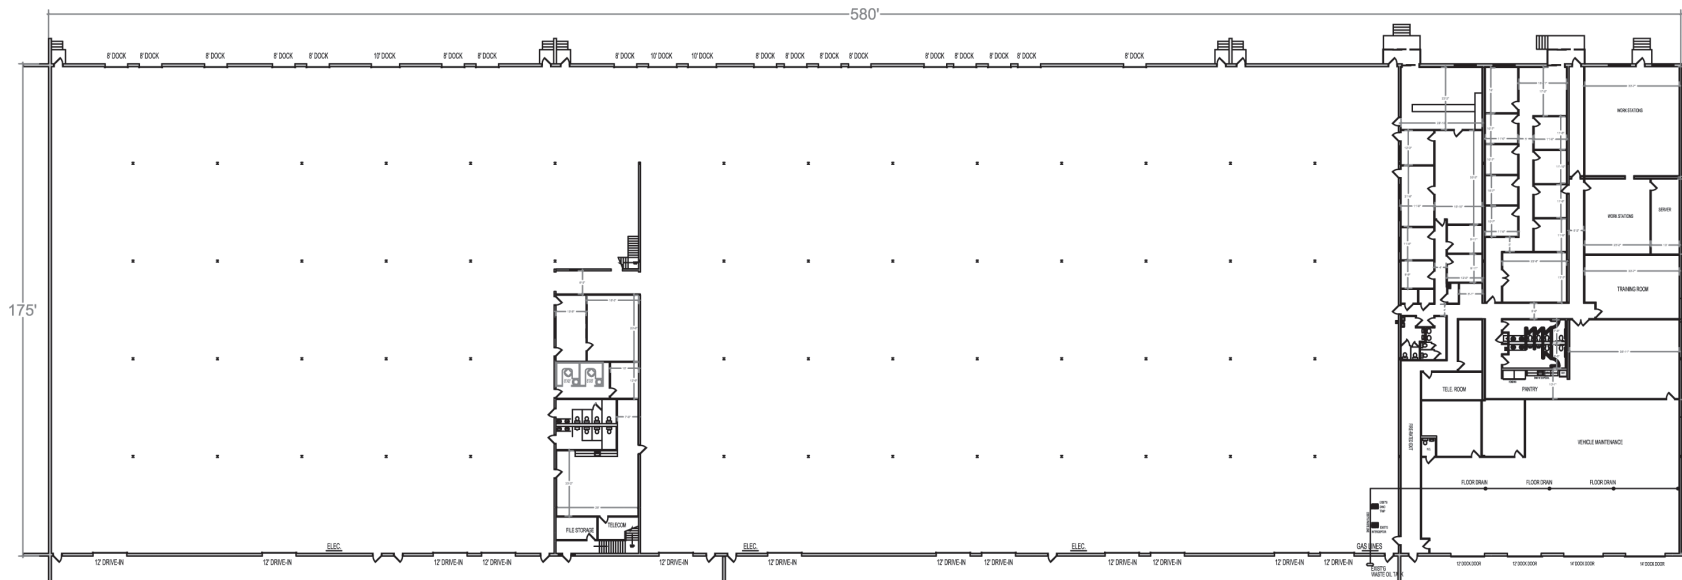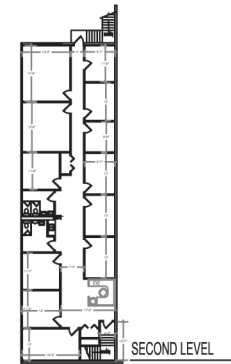

Plan not to scale - this is not a construction document.