


Total SF Office Available
20, 456 RSF
(Multi-tenant core factor 12%)

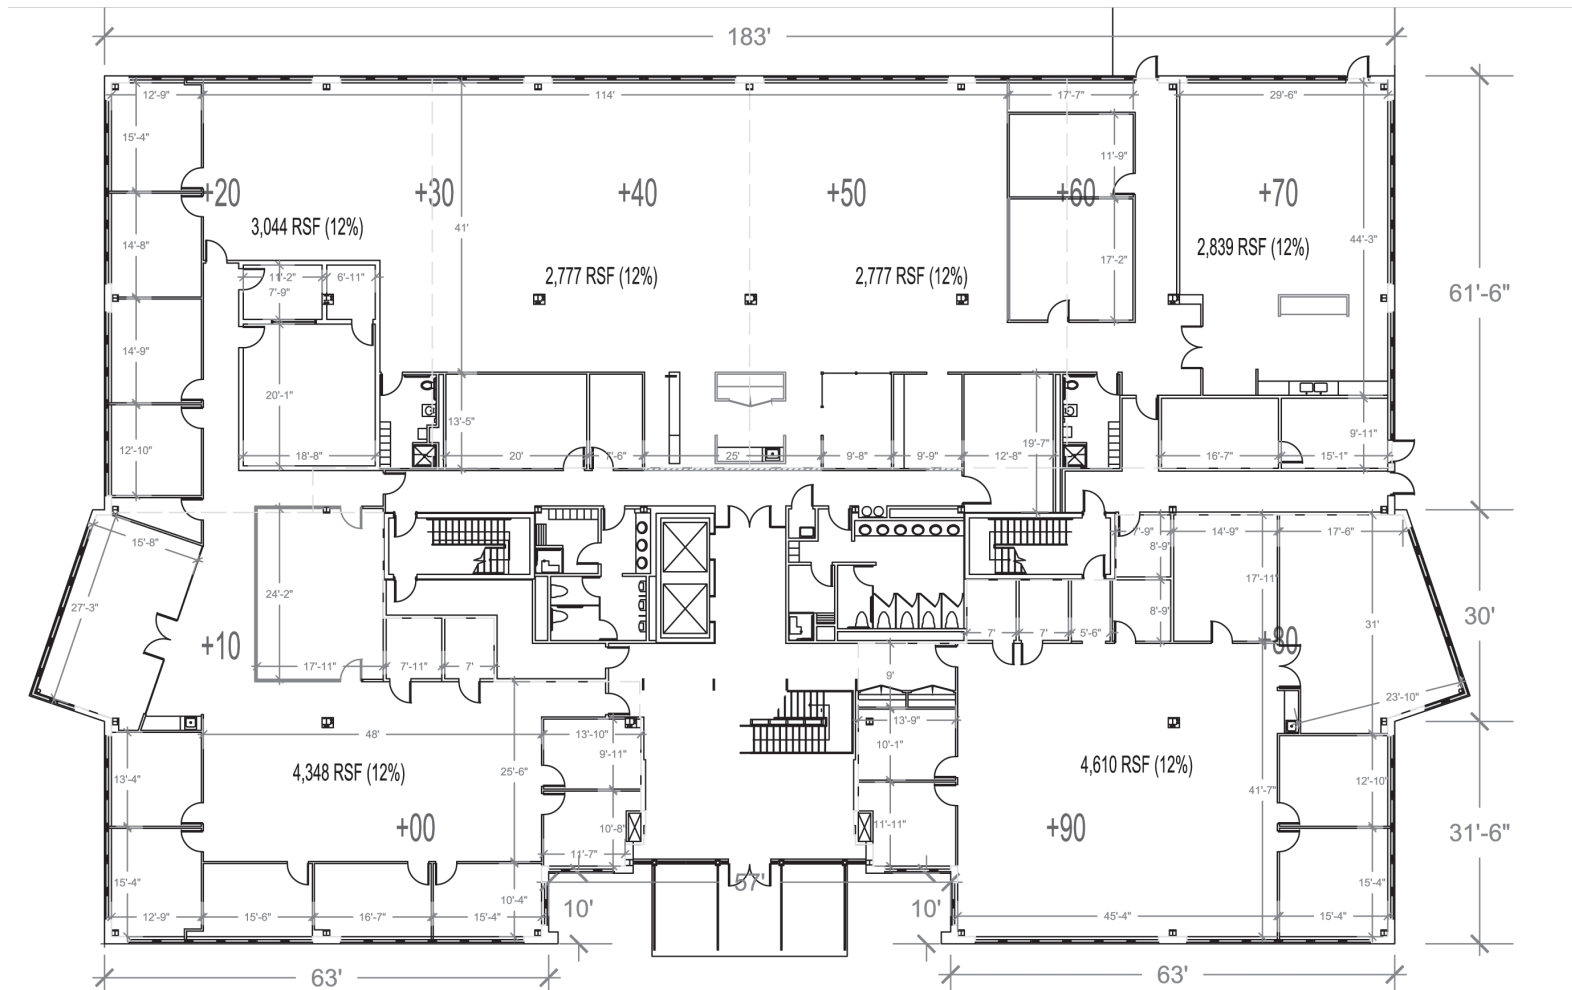

Plan not to scale - this is not a construction document.