


## Total SF Office Available 22,112 RSF

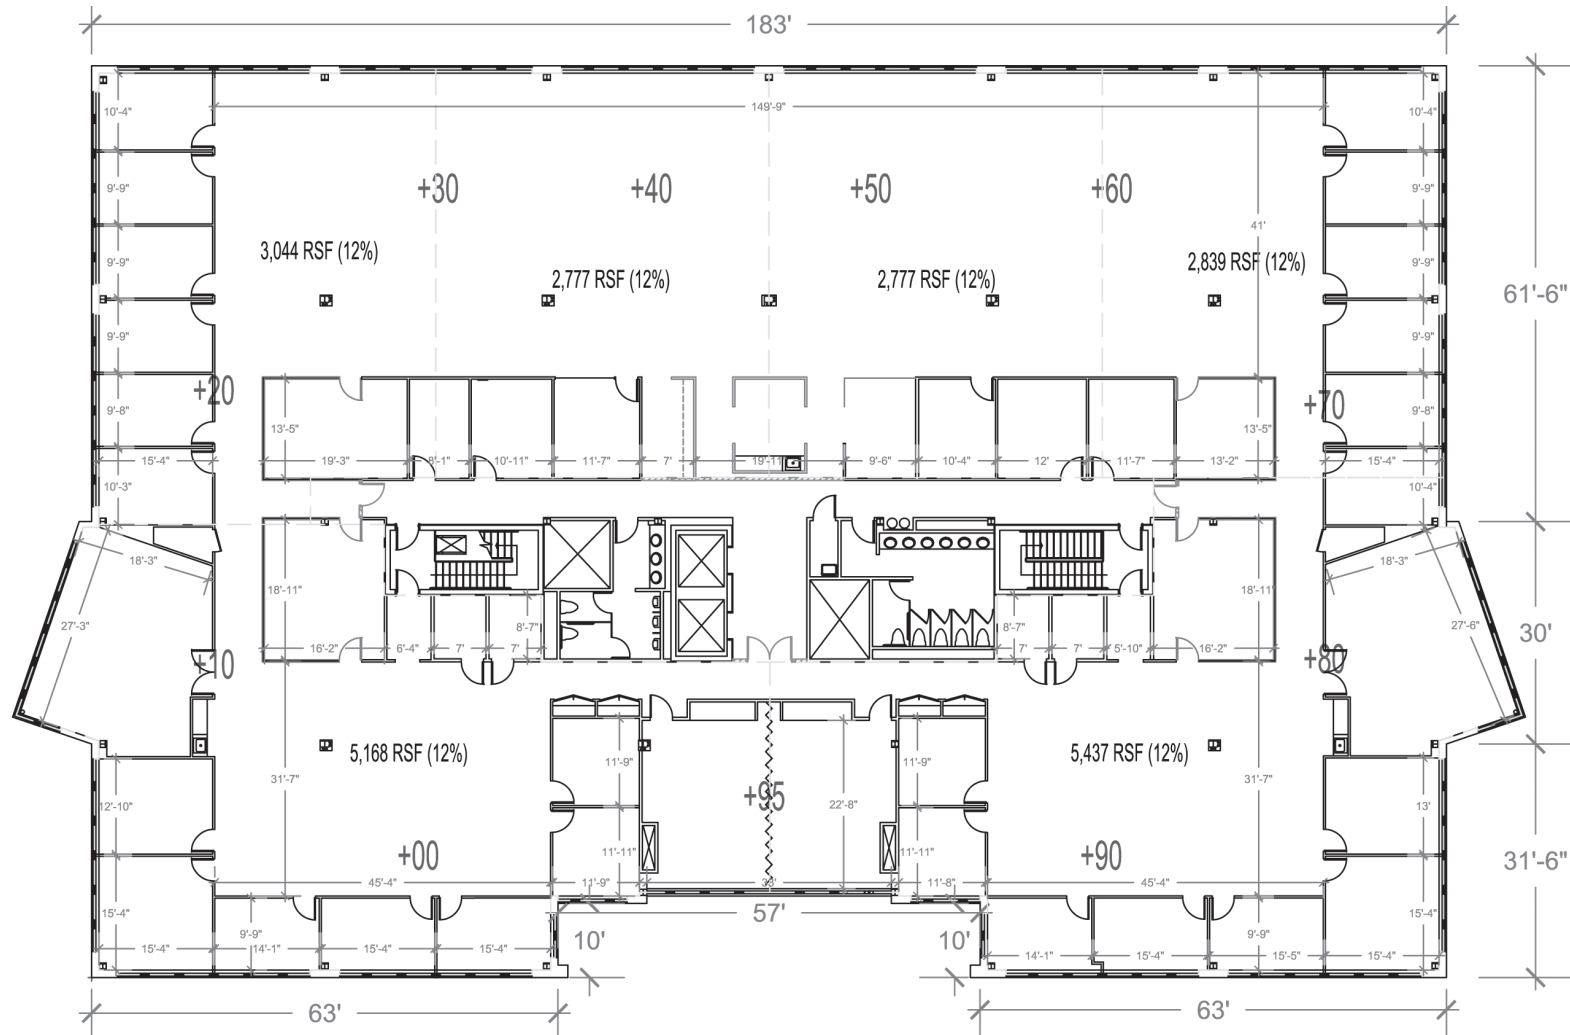

Plan not to scale - this is not a construction document.