


bwtech@UMBC

5523 Research Park Drive
Suite 110
Catonsville, MD 21228



Building Key Plan

Total SF Office Available
9,351 RSF

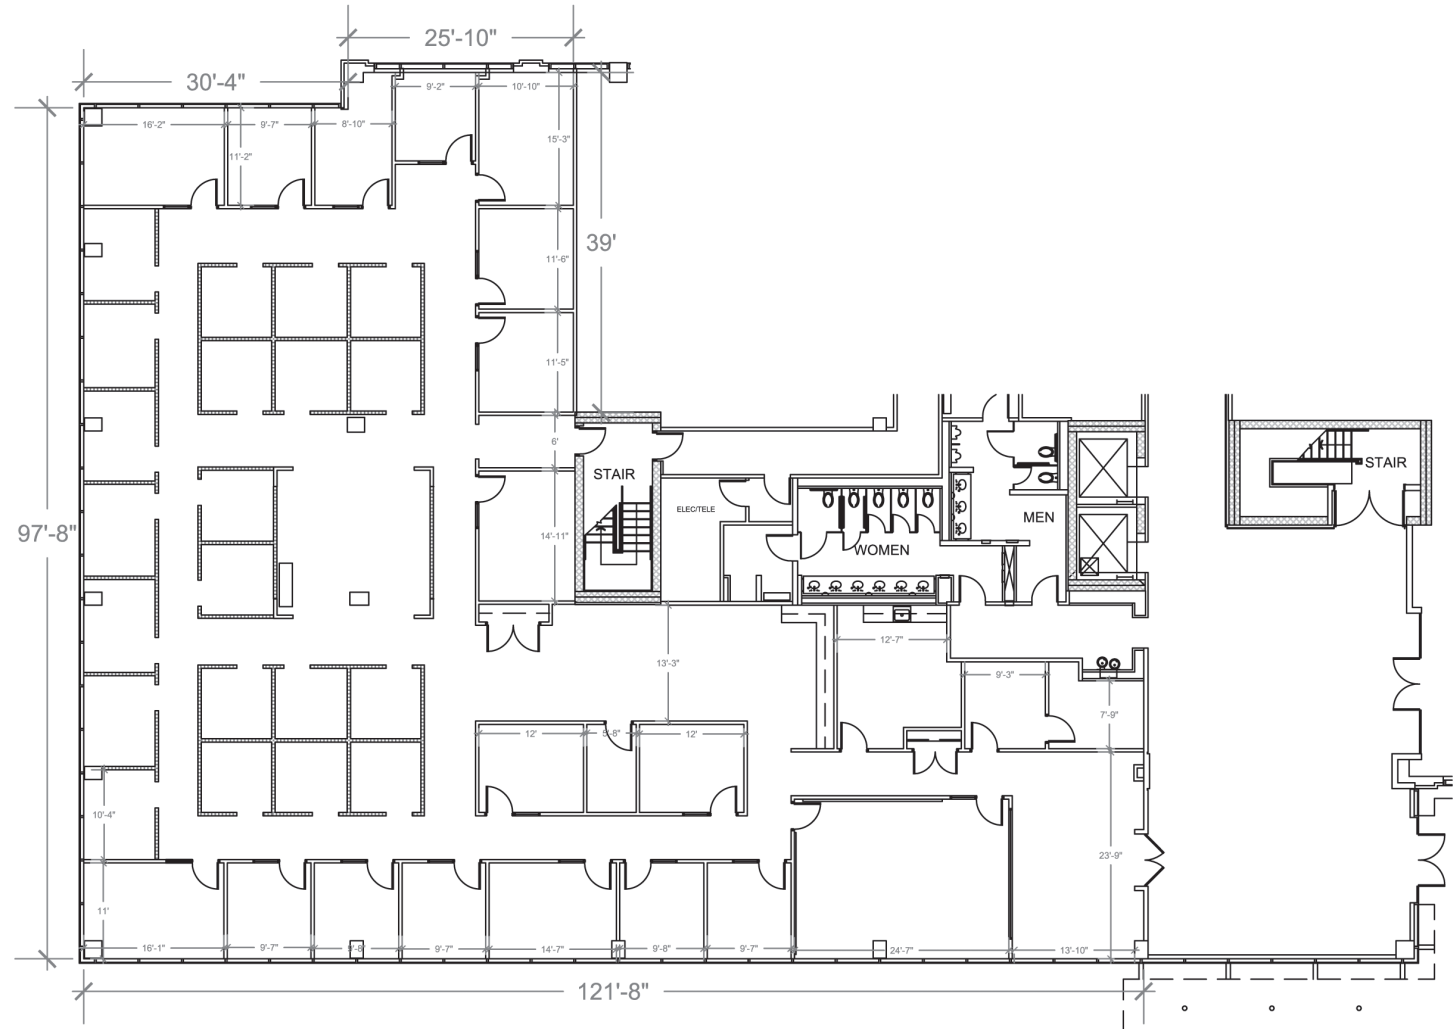

Plan not to scale - this is not a construction document.