


TOTAL SF AVAILABLE - 5,912 SF


OFFICE - 1,812 SF

WAREHOUSE - 4,106 SF

[Click to access 3D model](#)

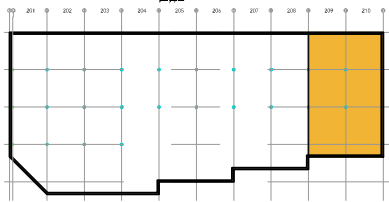

Key Plan

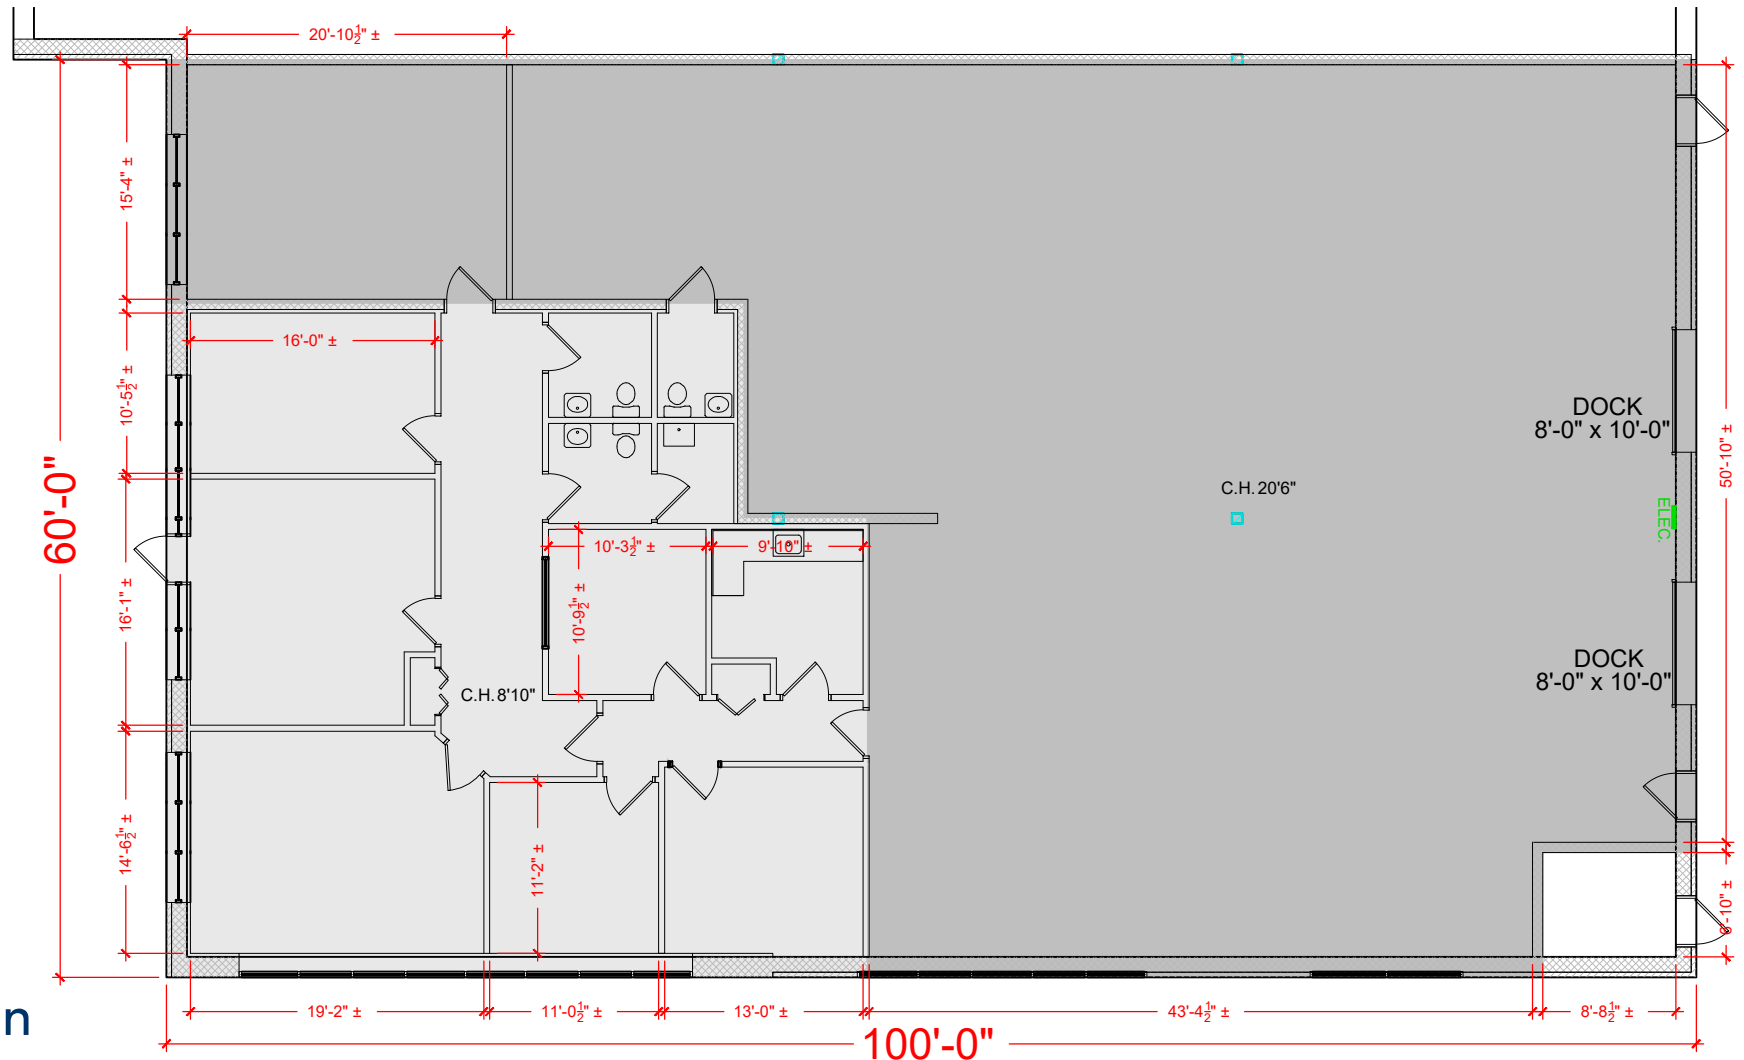

Floor Plan