

TOTAL SF AVAILABLE - 13,600 SF


OFFICE - 2,119 SF

WAREHOUSE - 11,481 SF

[Click to access 3D model](#)



Key Plan

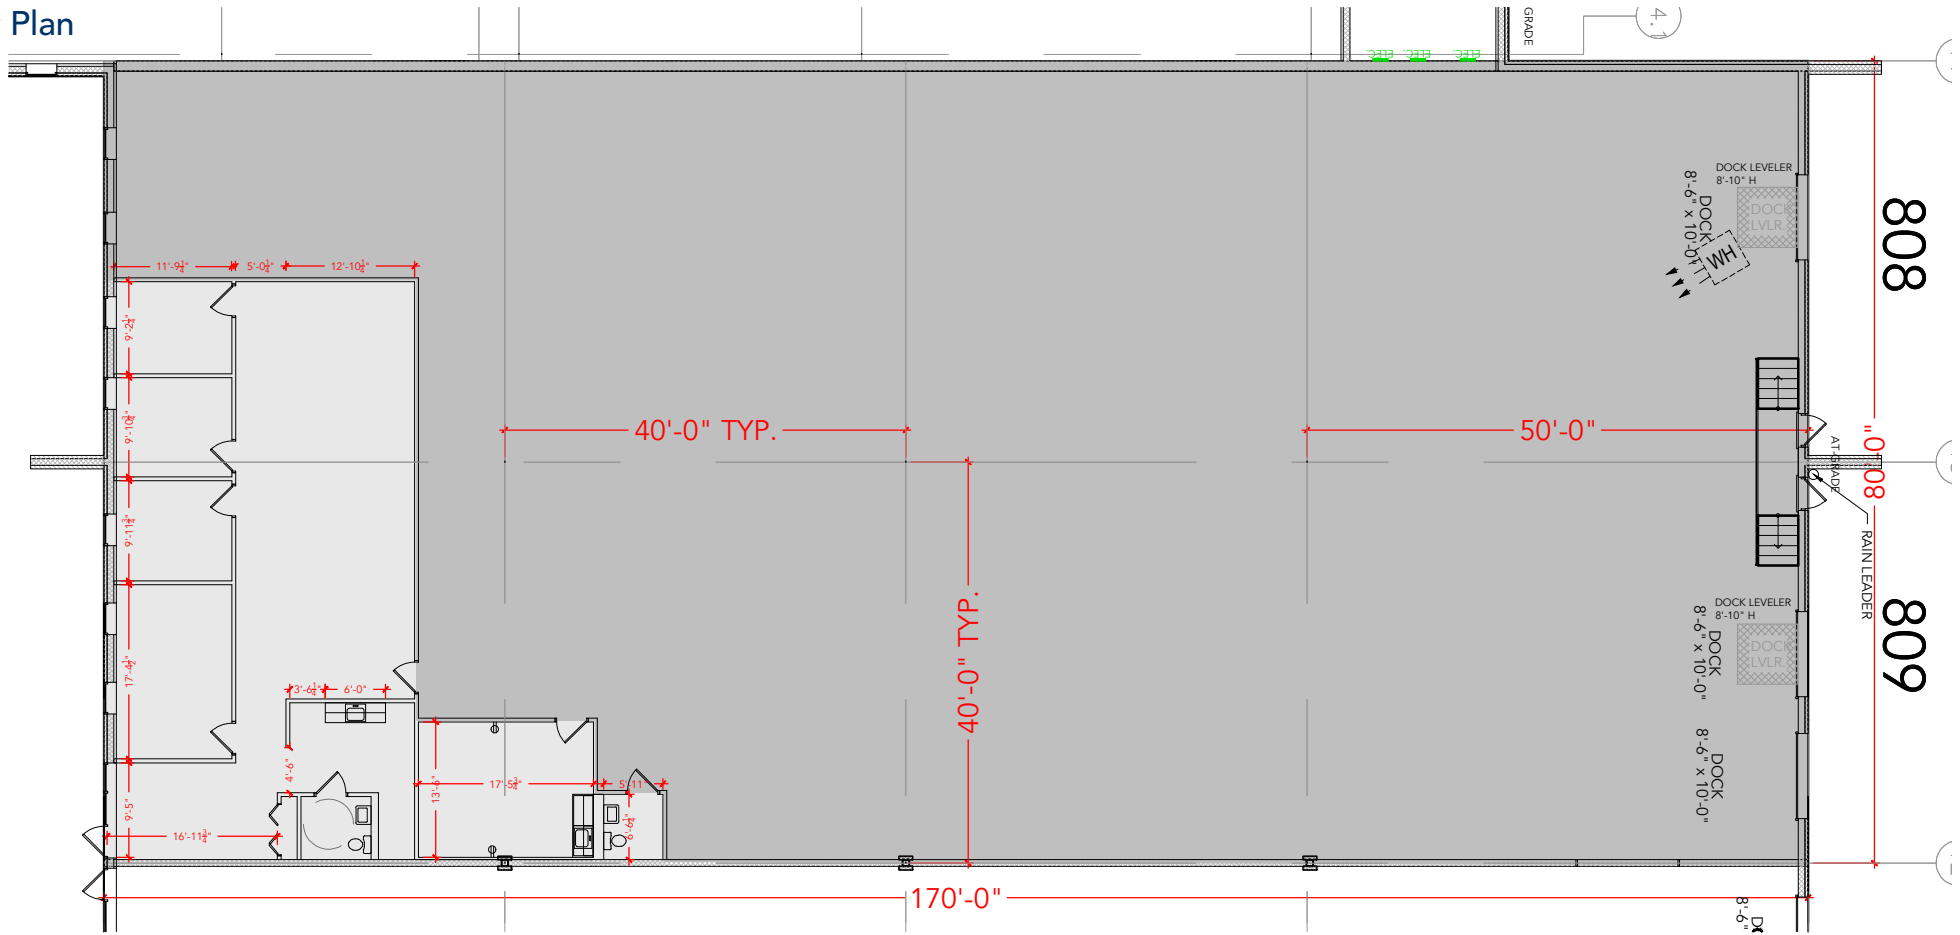

Floor Plan