


TOTAL SF AVAILABLE -2,700 SF


OFFICE - 808 SF

WAREHOUSE SF - 1,892 SF

[Click to access 3D model](#)

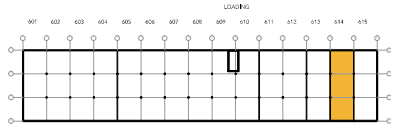

Key Plan

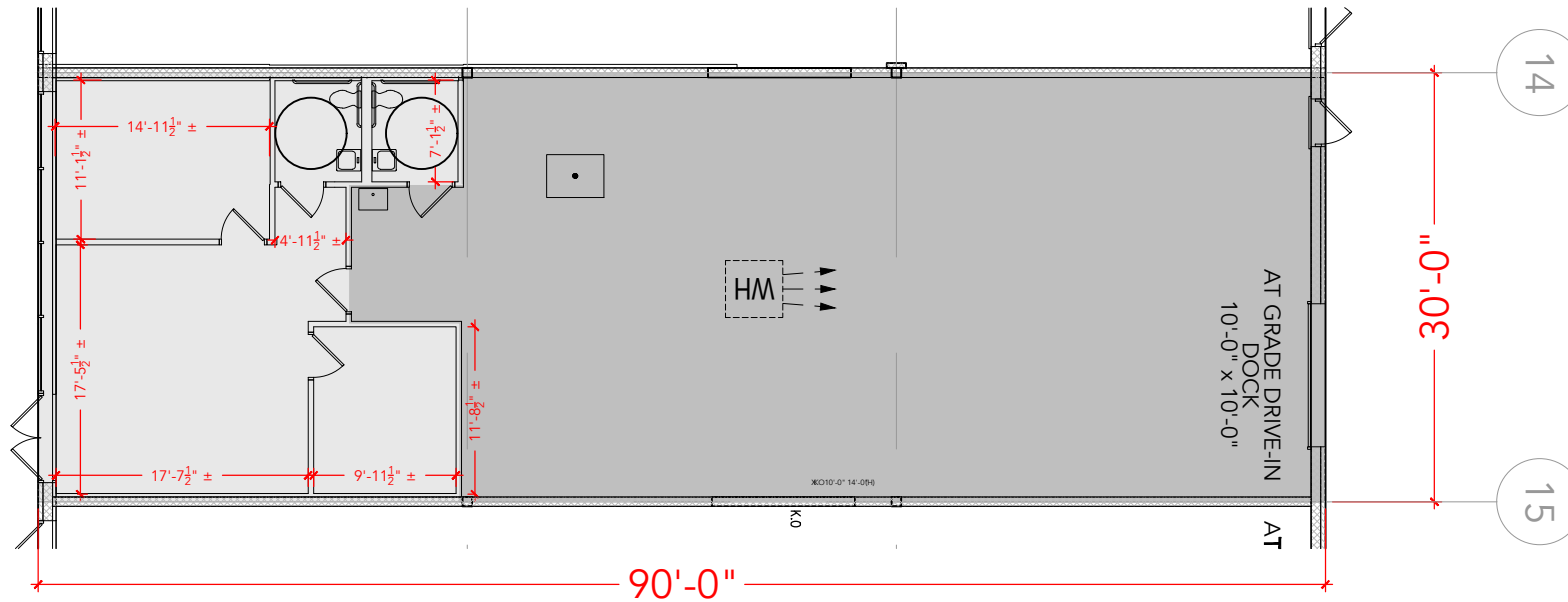

614

Floor Plan