



TOTAL SF AVAILABLE - 2,550 SF

OFFICE - 636 SF
WAREHOUSE - 1,914 SF

[Click to access 3D model](#)

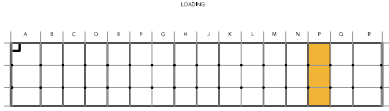

Key Plan

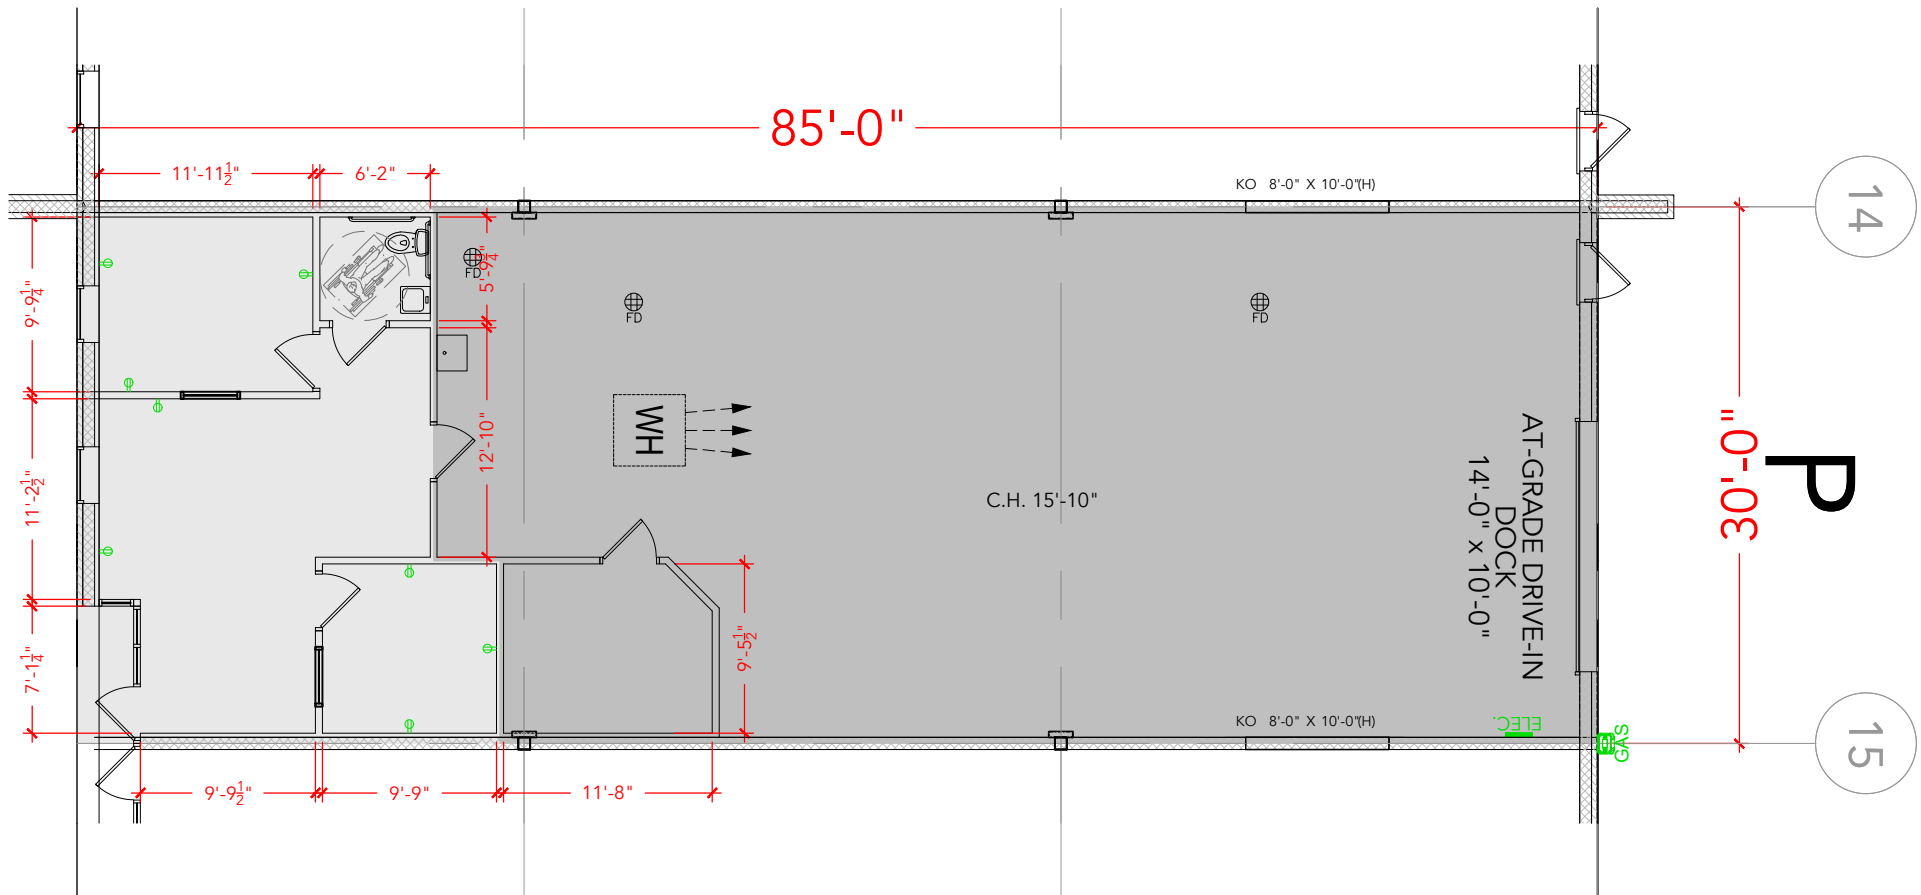

Floor Plan