


Key Plan

MULTI TENANT 6,214 RSF(12%)
SINGLE FLOOR USER 8,228 RSF(9%)

[Click to access 3D model](#)

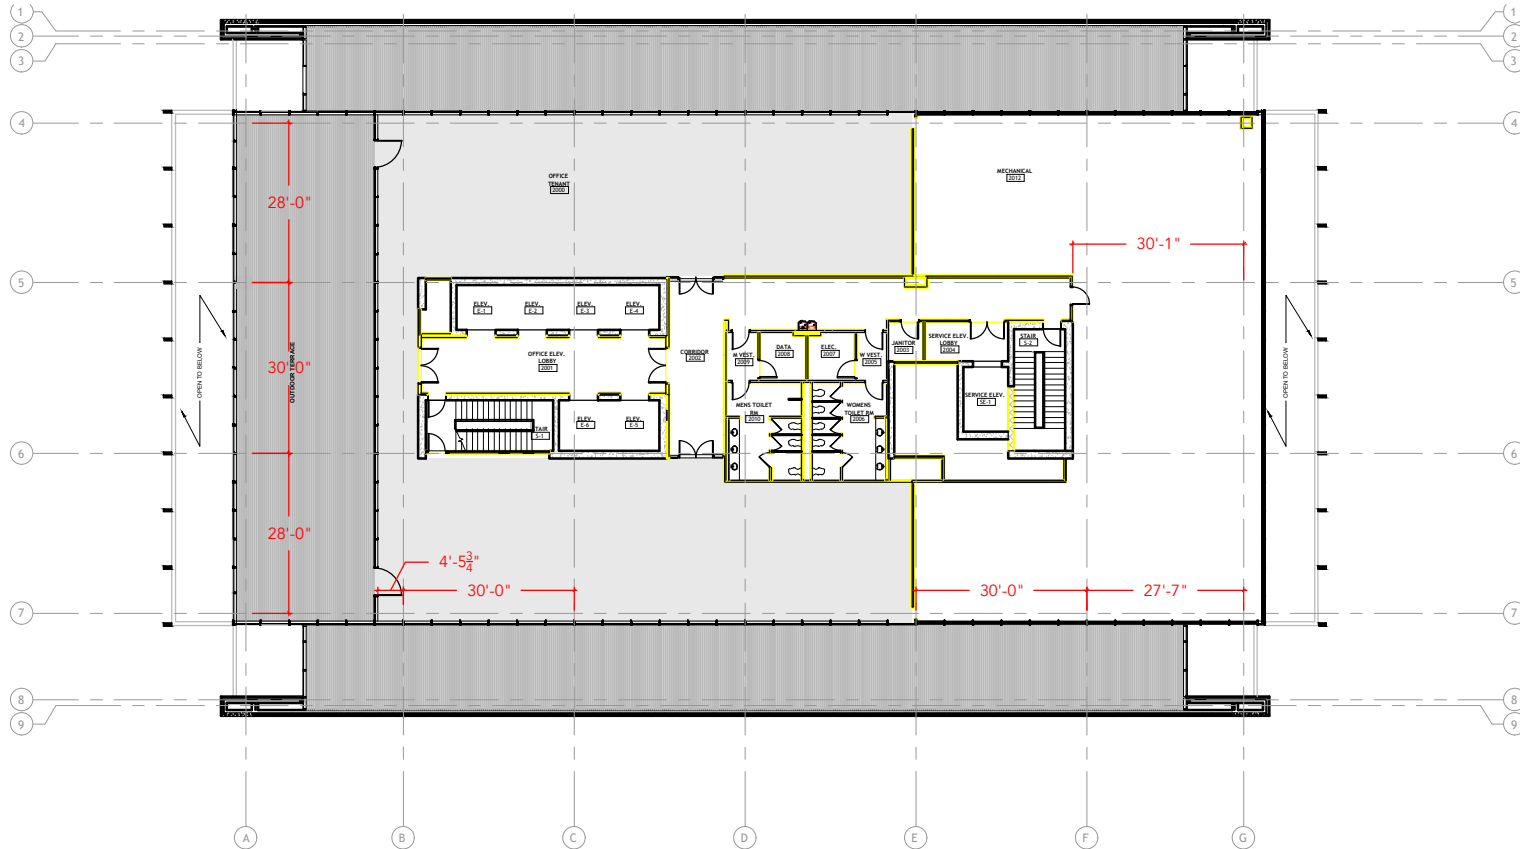

MULTI TENANT
SUITES TBD
LEVEL 20
6,214 RSF(12%)

Floor Plan