



TOTAL SF AVAILABLE - 2,918 RSF(12%)

[Click to access 3D model](#)

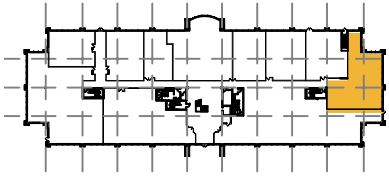

Key Plan

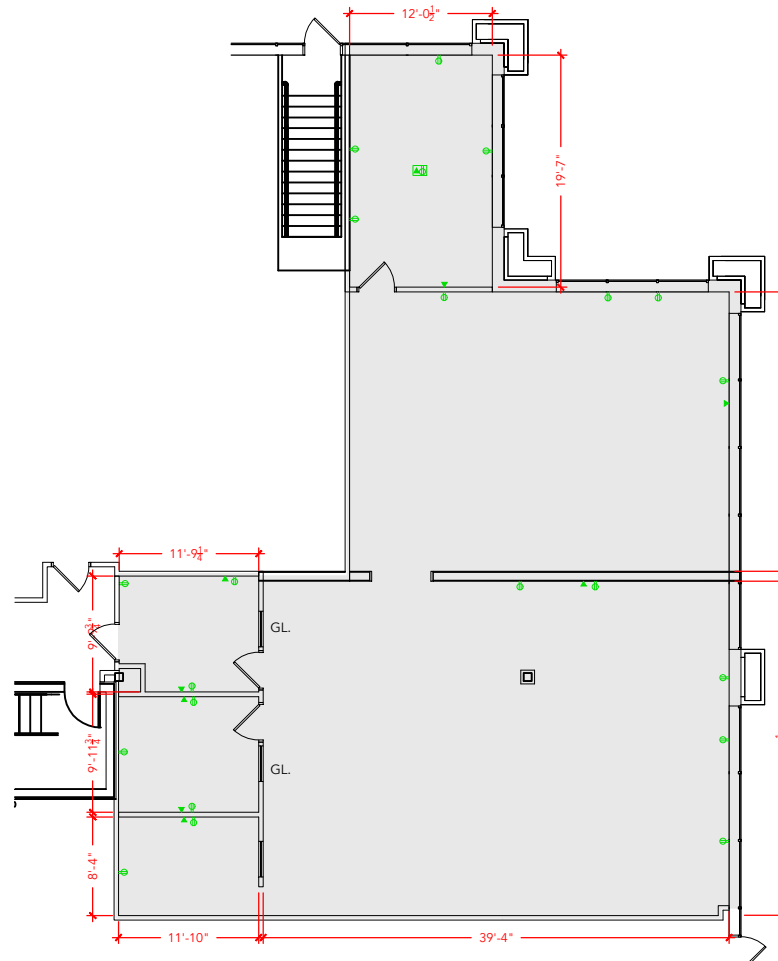

## Floor Plan