
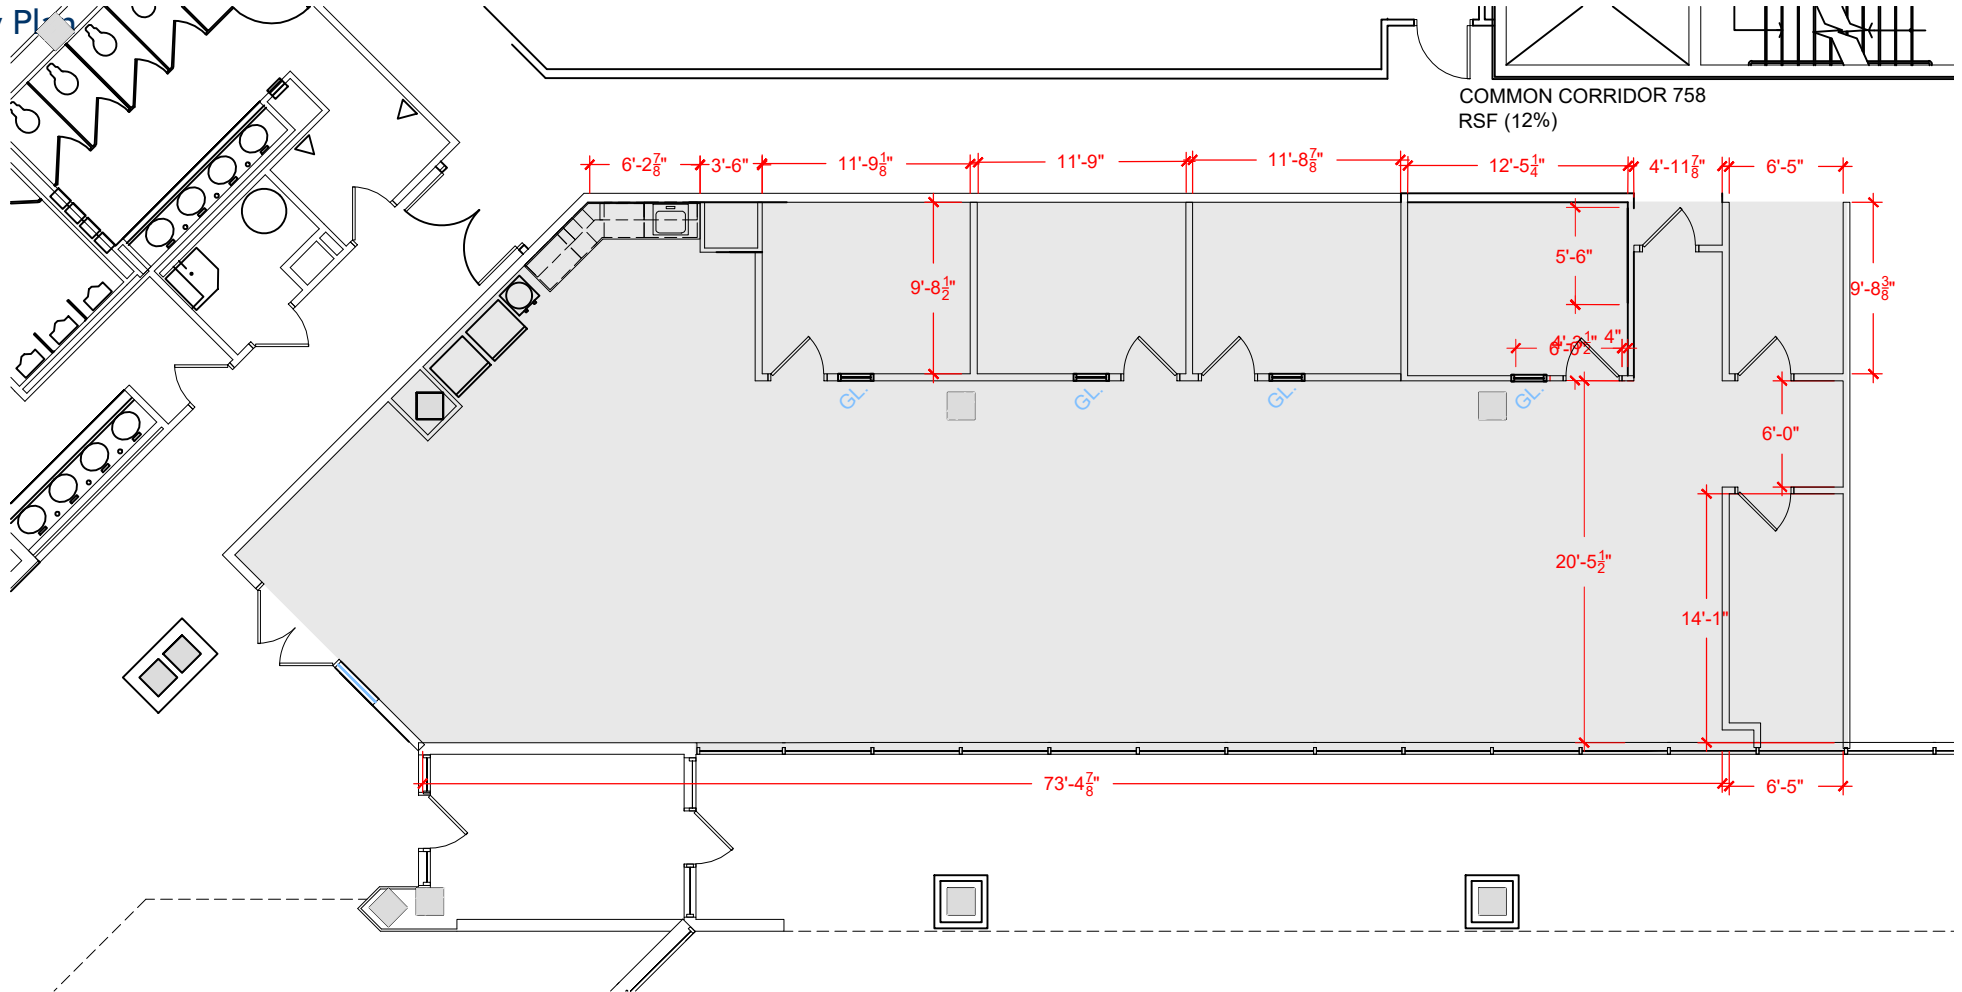


TOTAL SF AVAILABLE - 2,972 RSF(16%)

[Click to access 3D model](#)

Key Plan

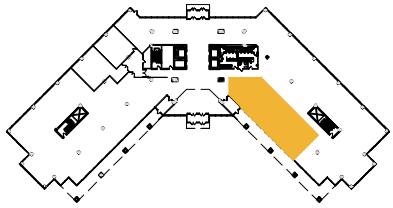

Floor Plan