


TOTAL SF AVAILABLE -6,910 RSF(16%)



Key Plan

[Click to access 3D model](#)

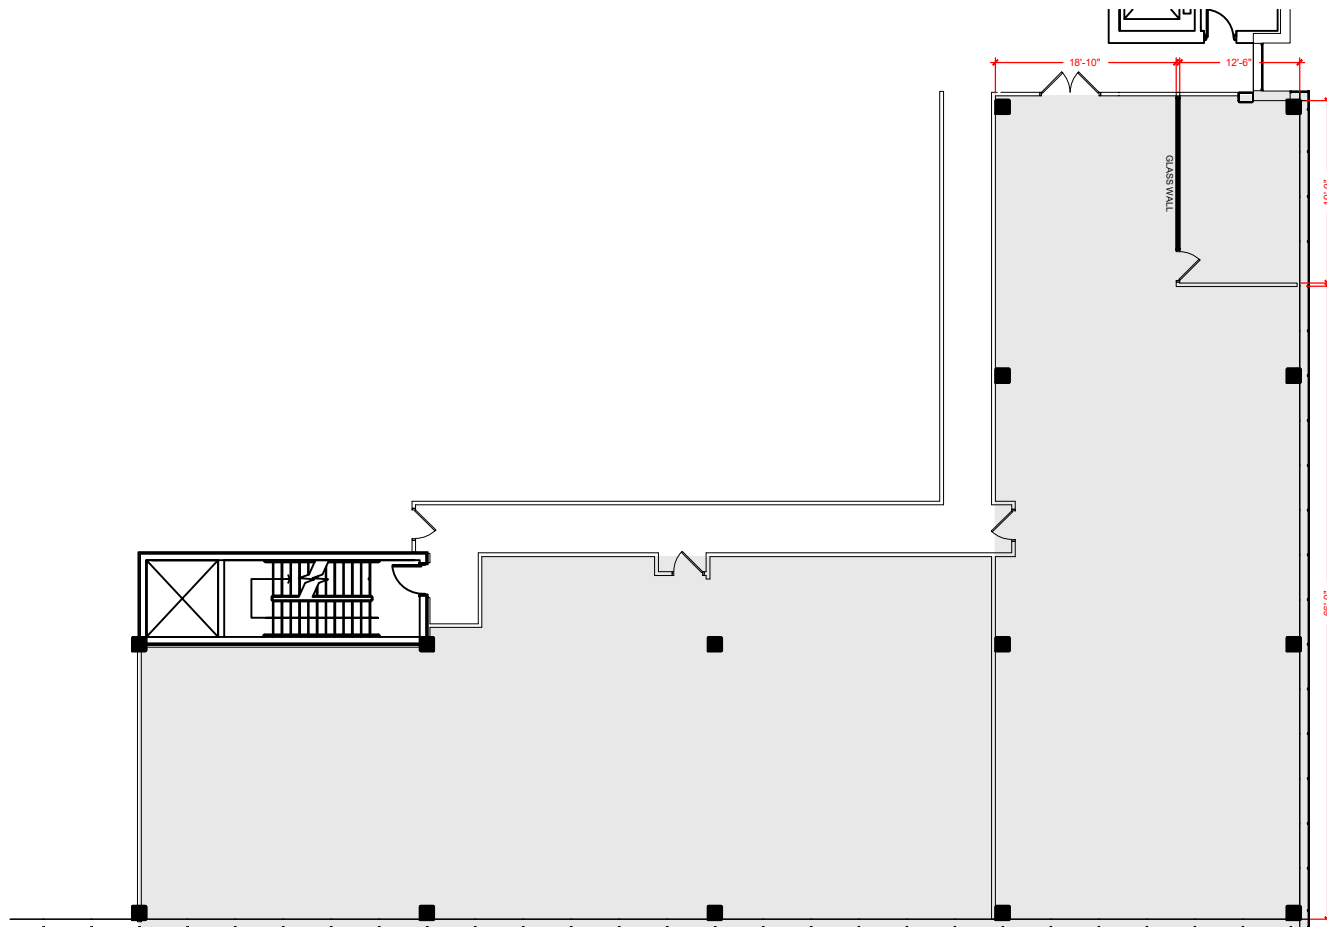

Floor Plan