



TOTAL SF AVAILABLE - 11,341 RSF(16%)

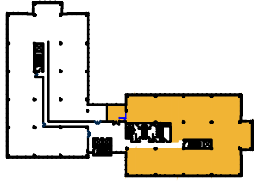

Key Plan

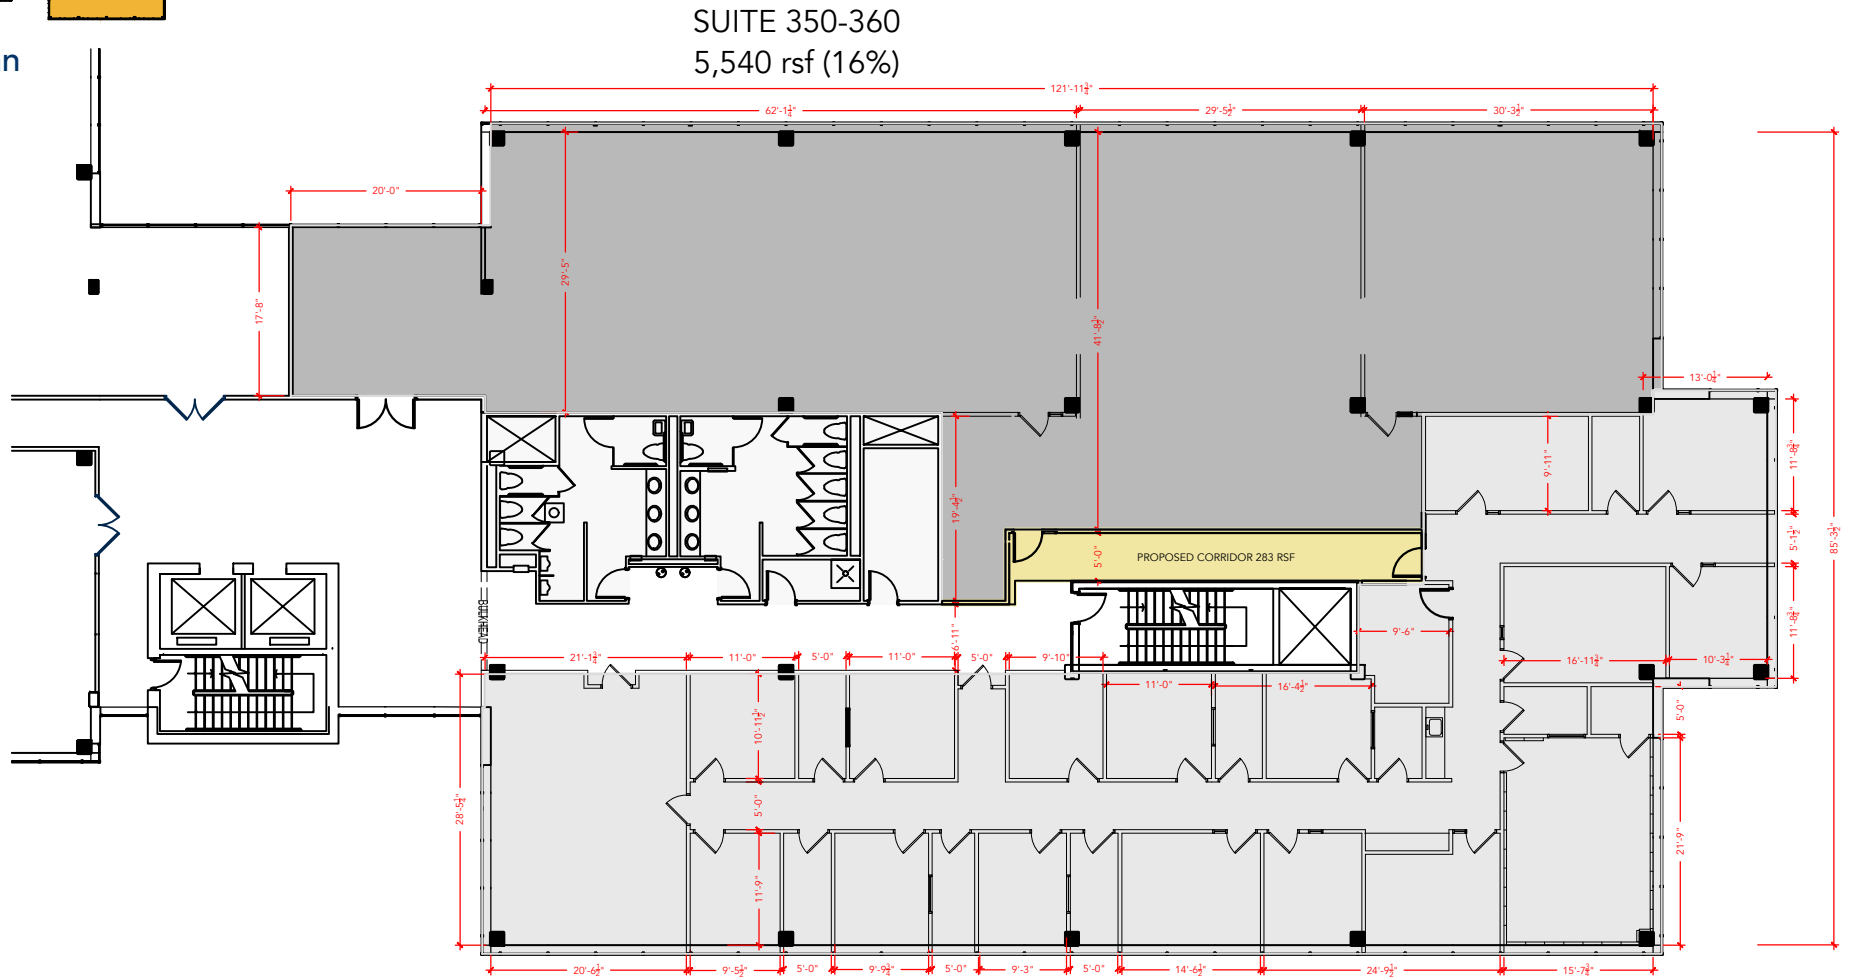

Floor Plan