



**TOTAL SF AVAILABLE - 2,320 SF**

OFFICE - 2,320 SF  
WAREHOUSE - 0,000 SF

[Click to access 3D model](#)

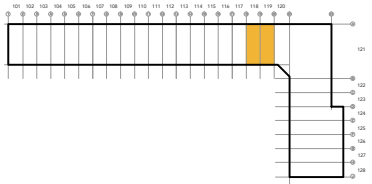

Key Plan

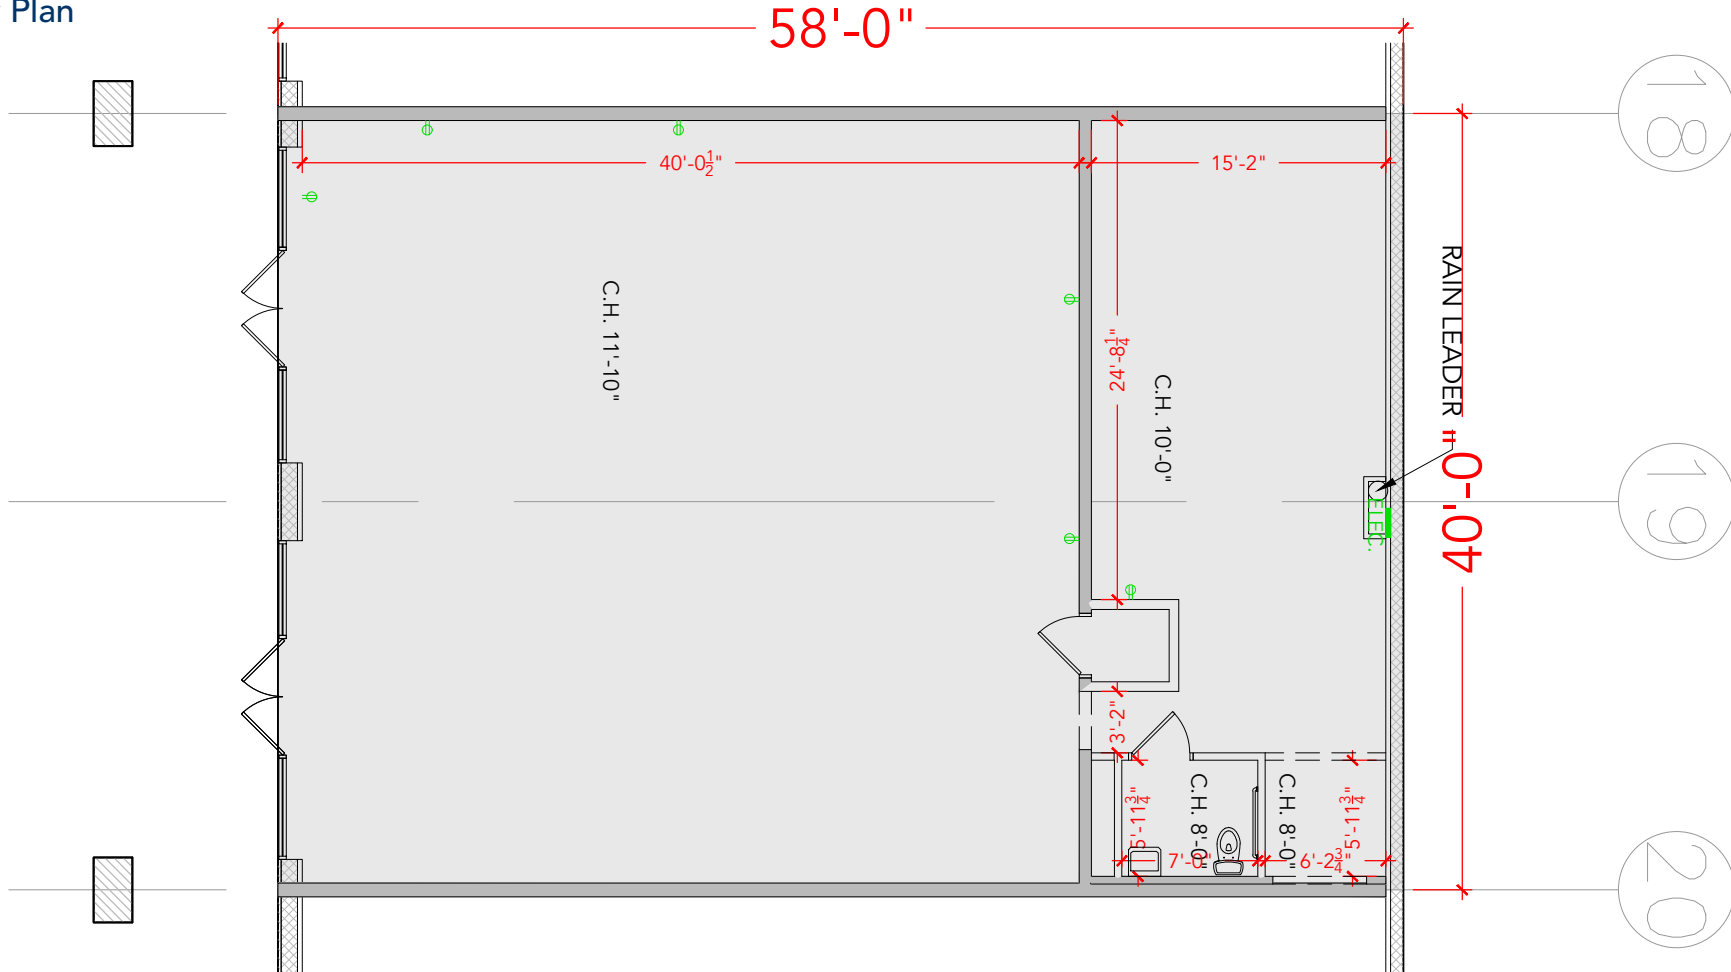

118 119

Floor Plan