



TOTAL SF AVAILABLE - 7,039 RSF

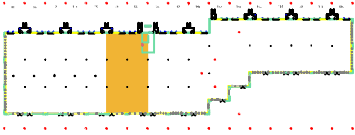

Key Plan

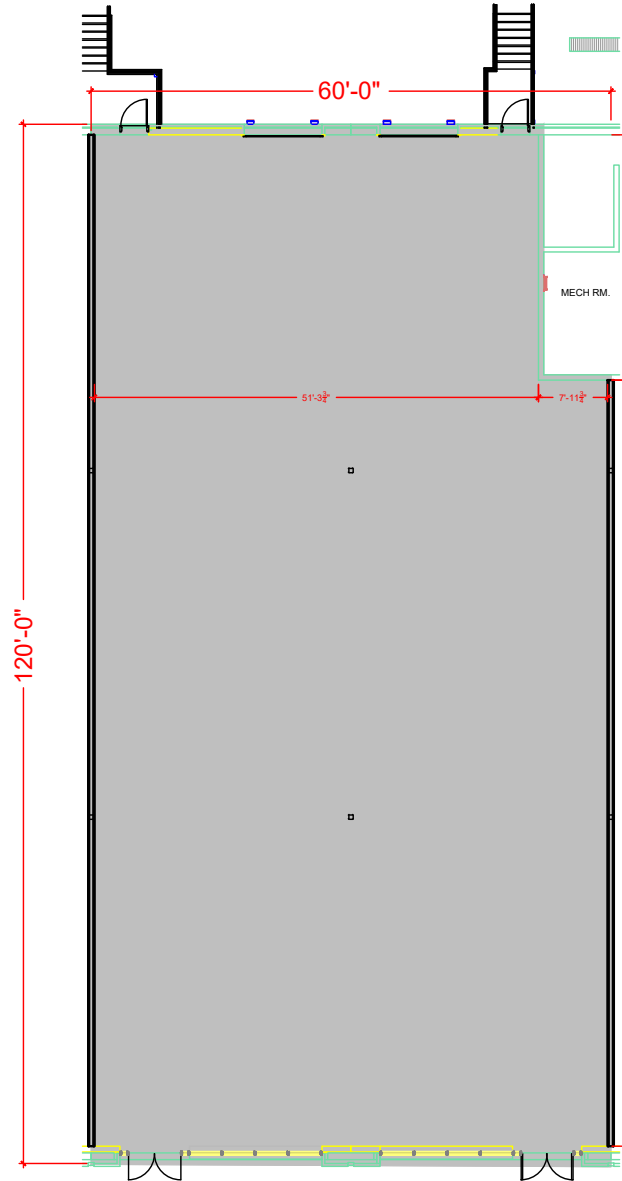

Floor Plan