


Key Plan

[Click to access 3D model](#)

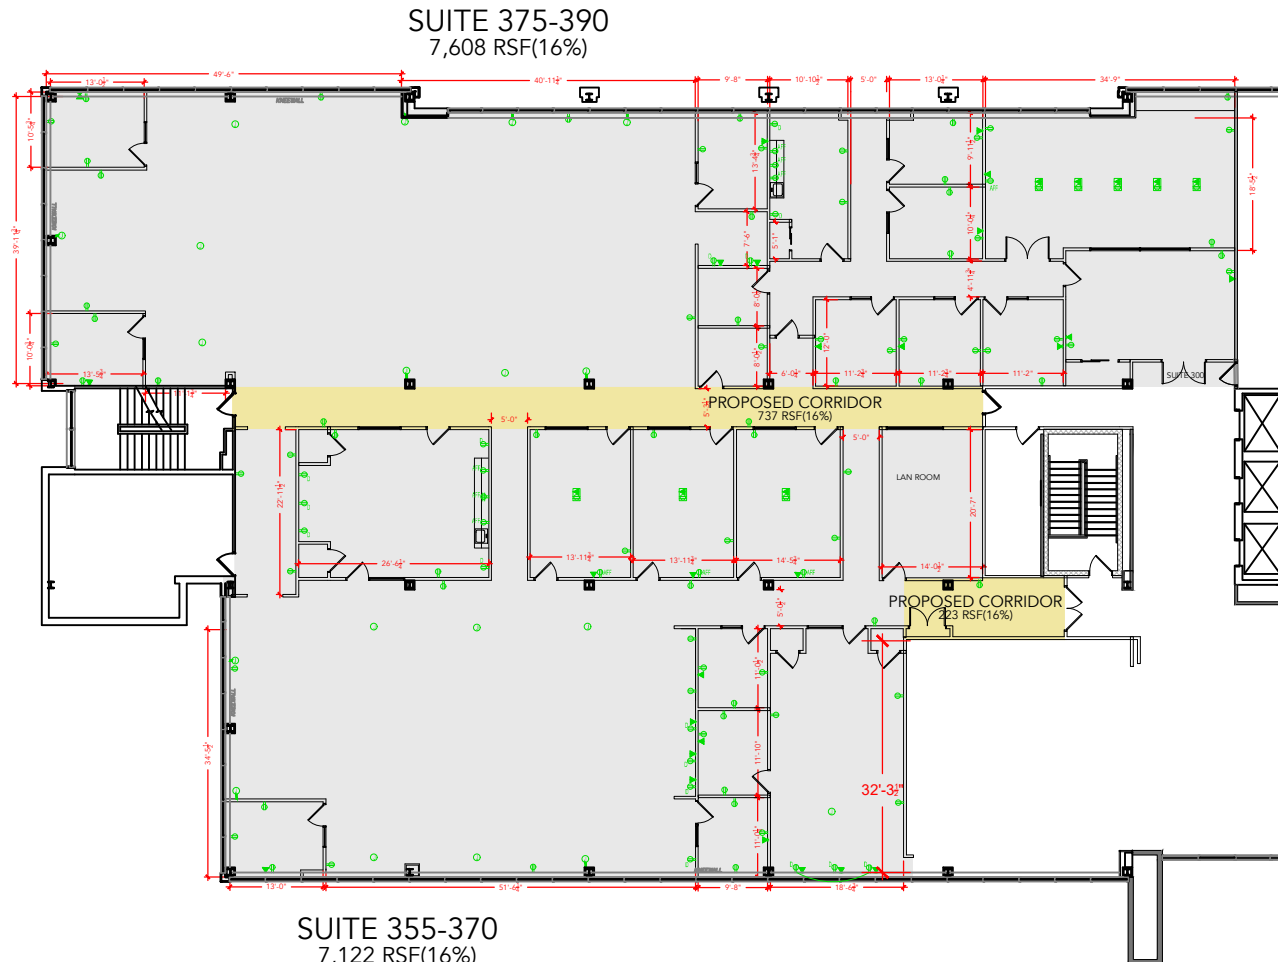

## Floor Plan