


**TOTAL SF AVAILABLE -9,300 SF**


OFFICE - 331 SF

WAREHOUSE - 8,969 SF

[Click to access 3D model](#)

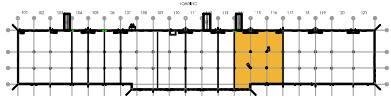

Key Plan

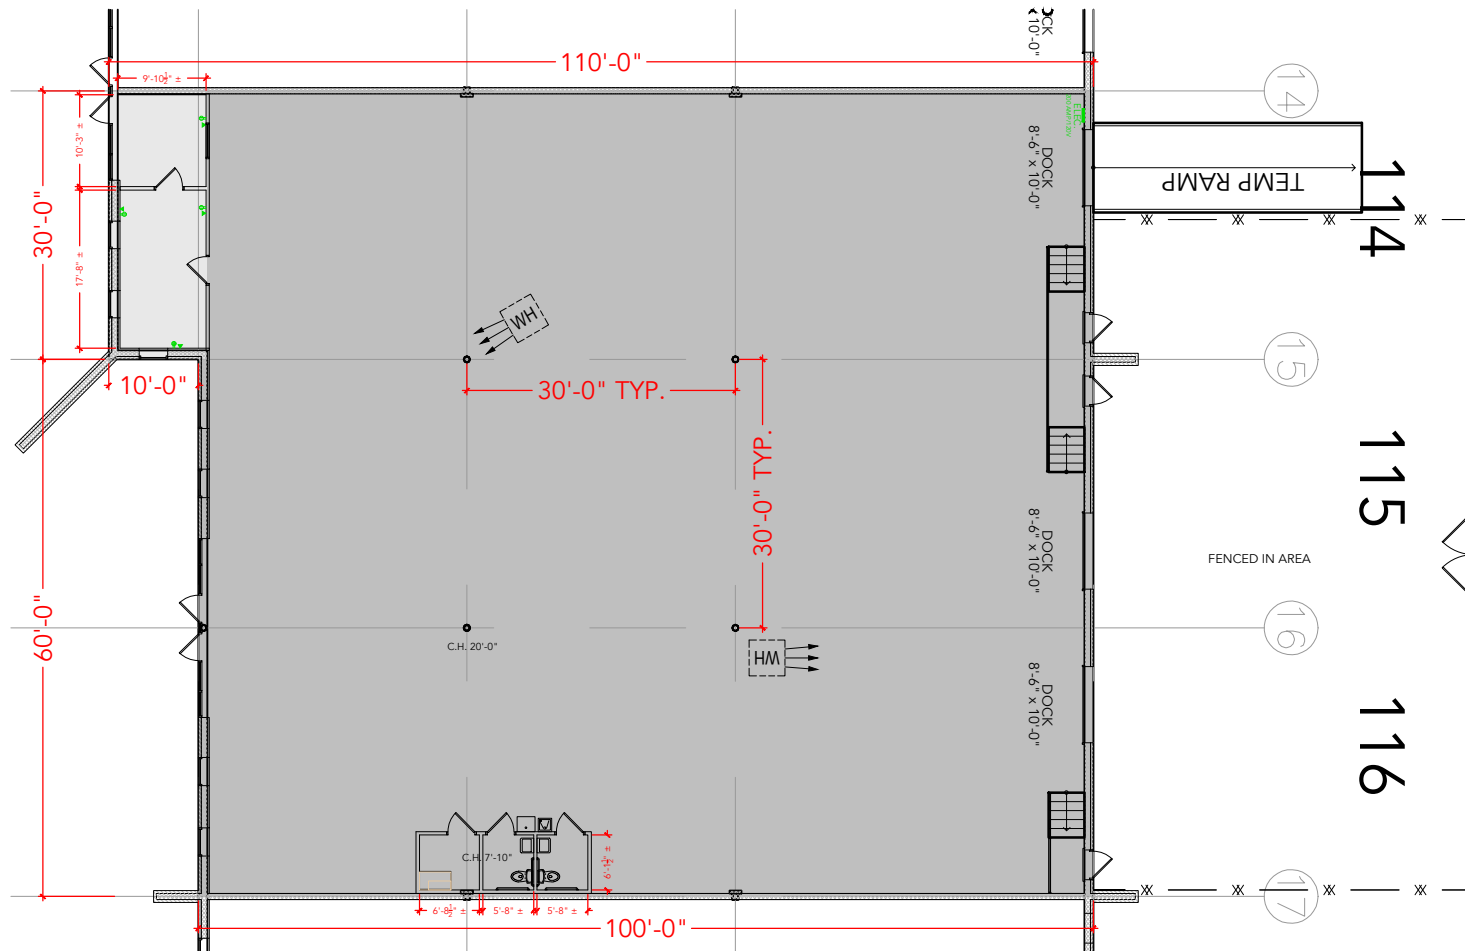

Floor Plan