



TOTAL SF AVAILABLE - 2,432 RSF (12.6%)

[Click to access 3D model](#)

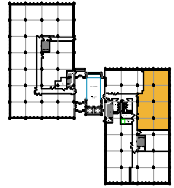

Key Plan

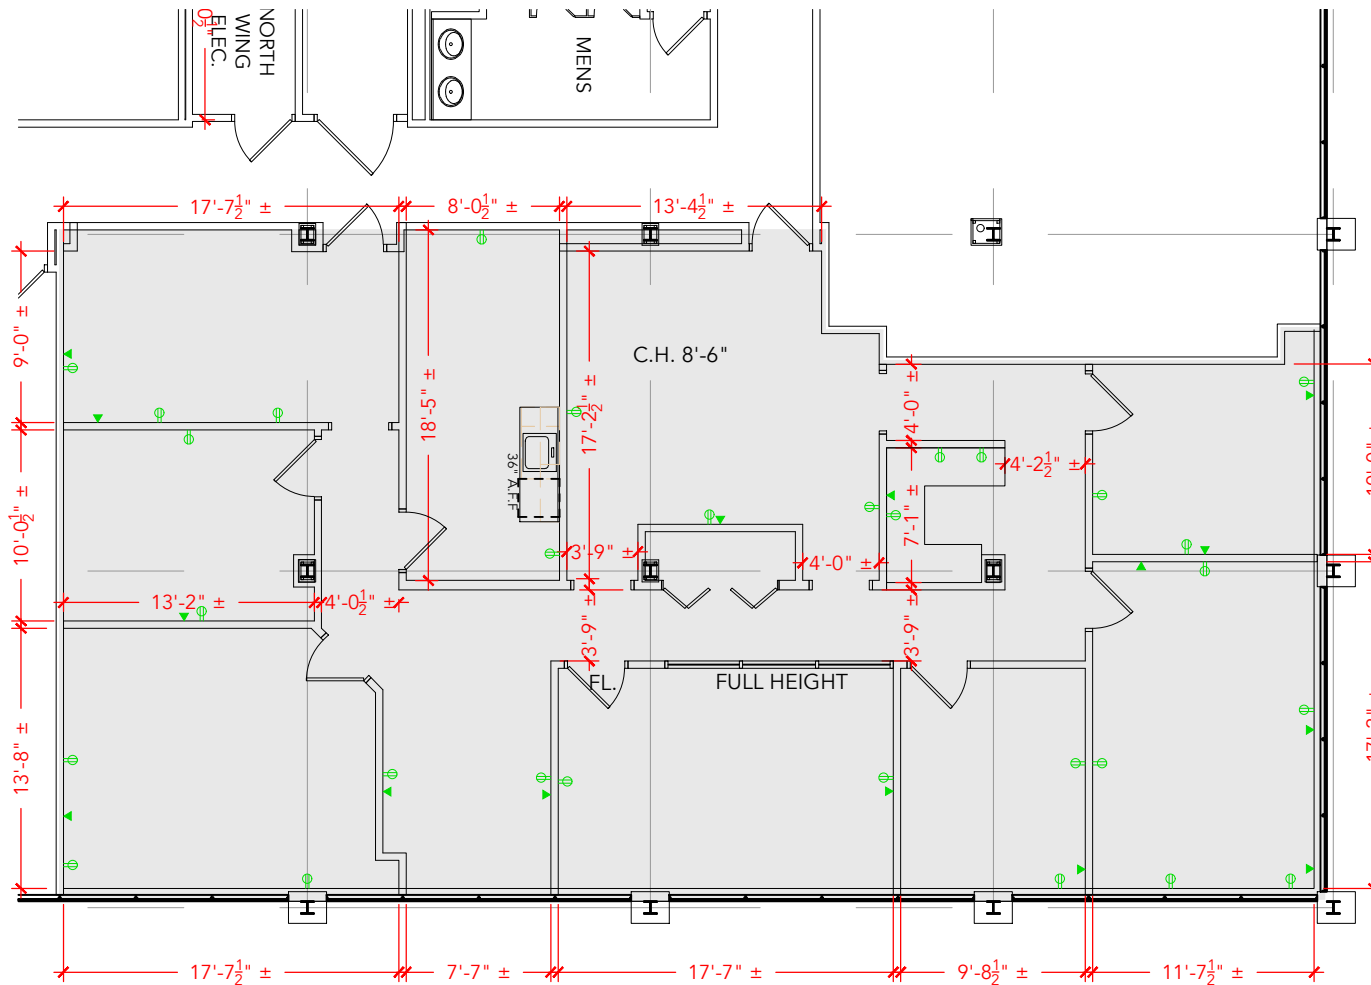

Floor Plan