



TOTAL SF AVAILABLE - 1,898 RSF (12.6%)

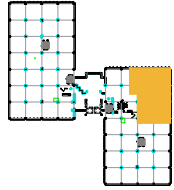

Key Plan

[Click to access 3D model](#)

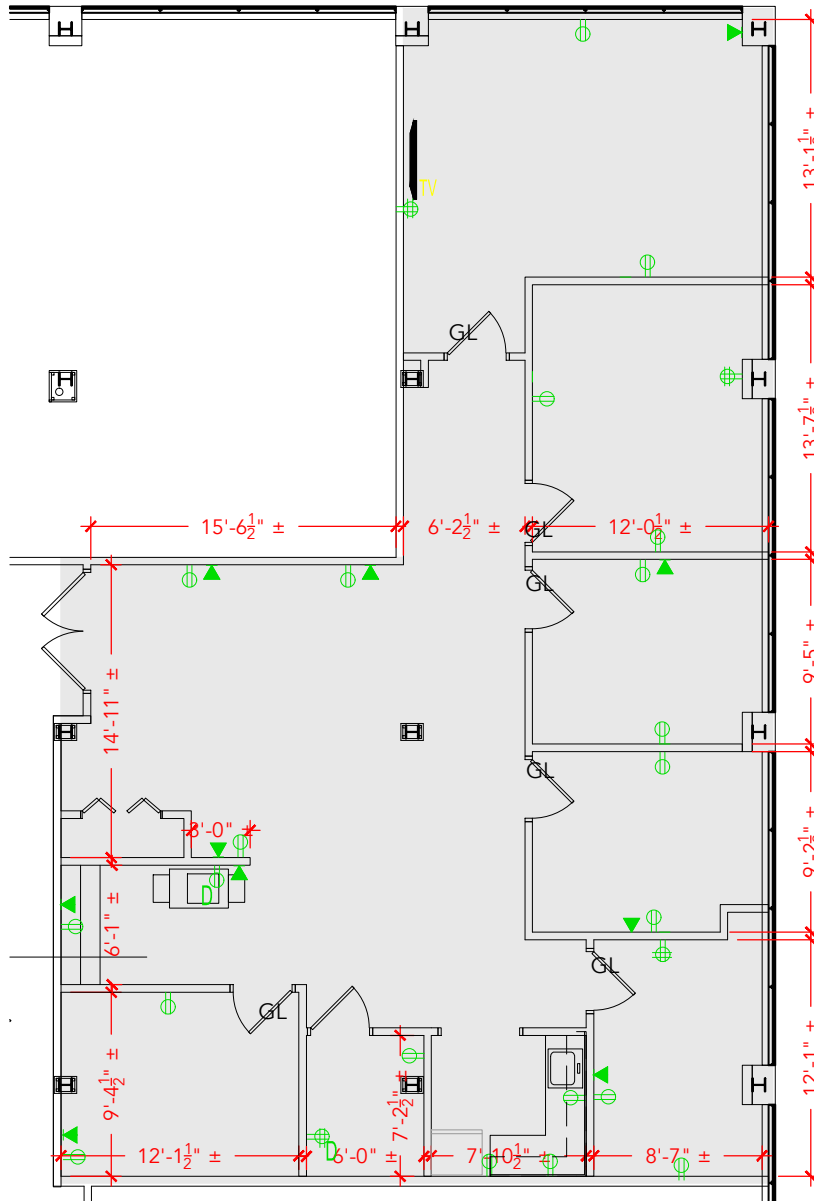

Floor Plan