


TOTAL SF AVAILABLE - 4,262 RSF (12%)

SUITE 240-240 - 3,059 RSF(12%)


MEZZANINE 240M - 1,203 RSF (12%)

[Click to access 3D model](#)

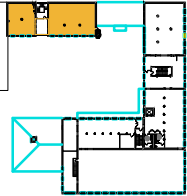


Key Plan

240M

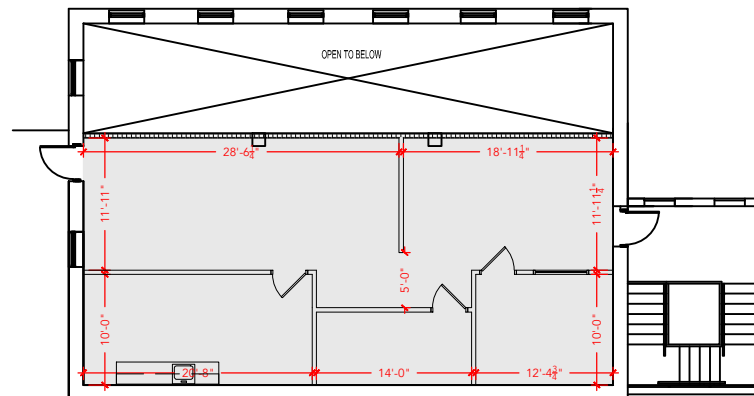

240

245

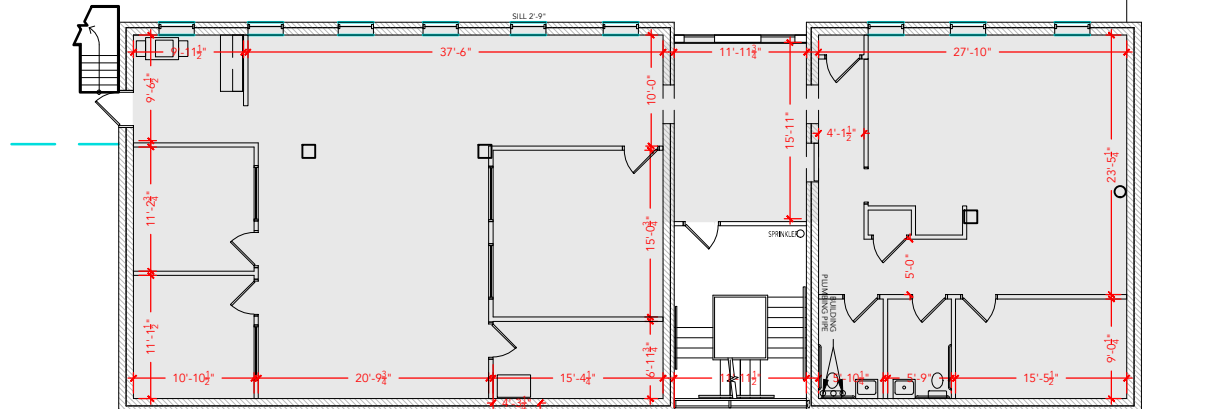

Floor Plan