


TOTAL SF AVAILABLE - 2,156 RSF(12%)


OFFICE - 468 RSF(12%)

WAREHOUSE - 1,688 RSF(12%)

[Click to access 3D model](#)

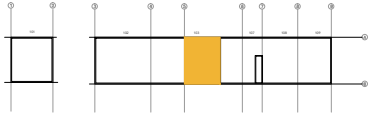

Key Plan

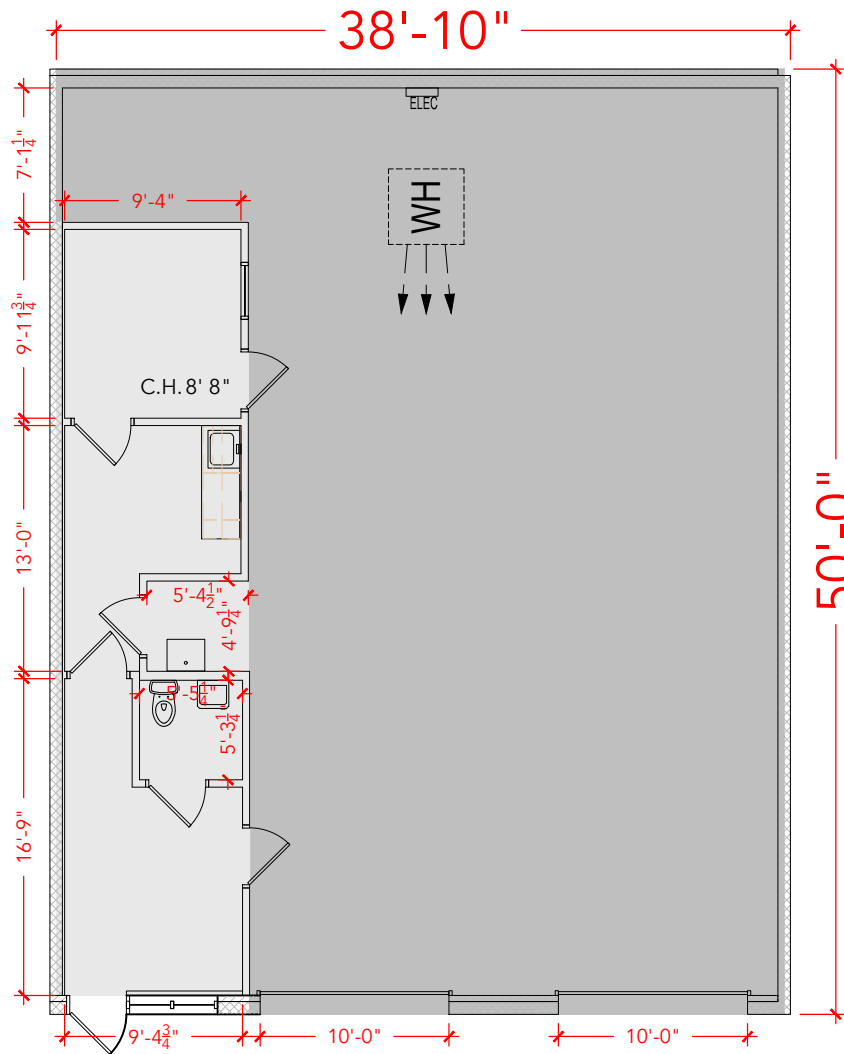

Floor Plan