


TOTAL SF AVAILABLE - 14,250 SF


OFFICE - 1,332 SF

WAREHOUSE - 12,918 SF

[Click to access 3D model](#)

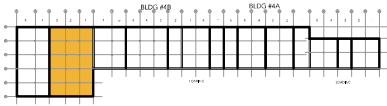

Key Plan

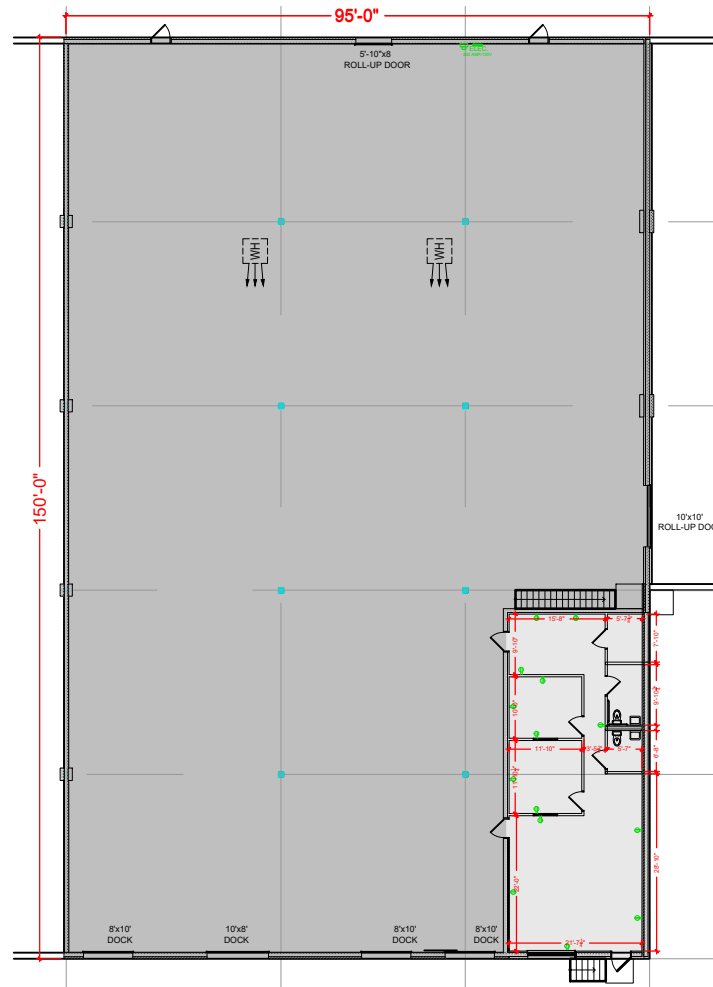

Floor Plan