



TOTAL SF AVAILABLE - 3,600 SF

OFFICE - 900 SF
WAREHOUSE SF - 2,700 SF

[Click to access 3D model](#)

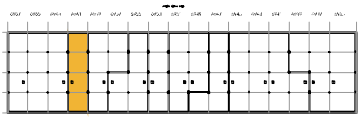

Key Plan

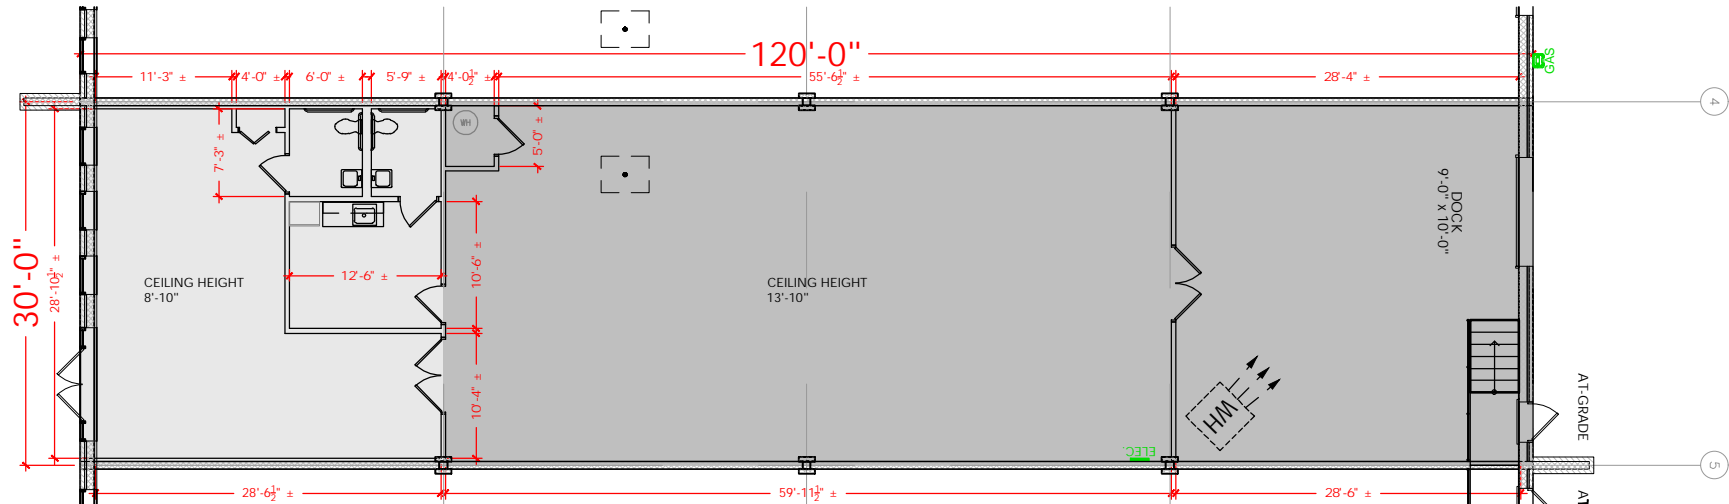

6961

Floor Plan