



TOTAL SF AVAILABLE - 6,471 RSF(12%)

* LOFT 492 RSF(12%) NOT INCLUDED IN TOTAL RSF
[Click to access 3D model](#)

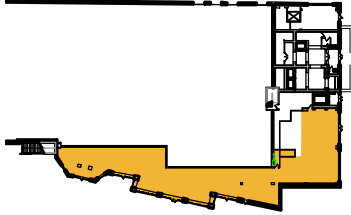

Key Plan

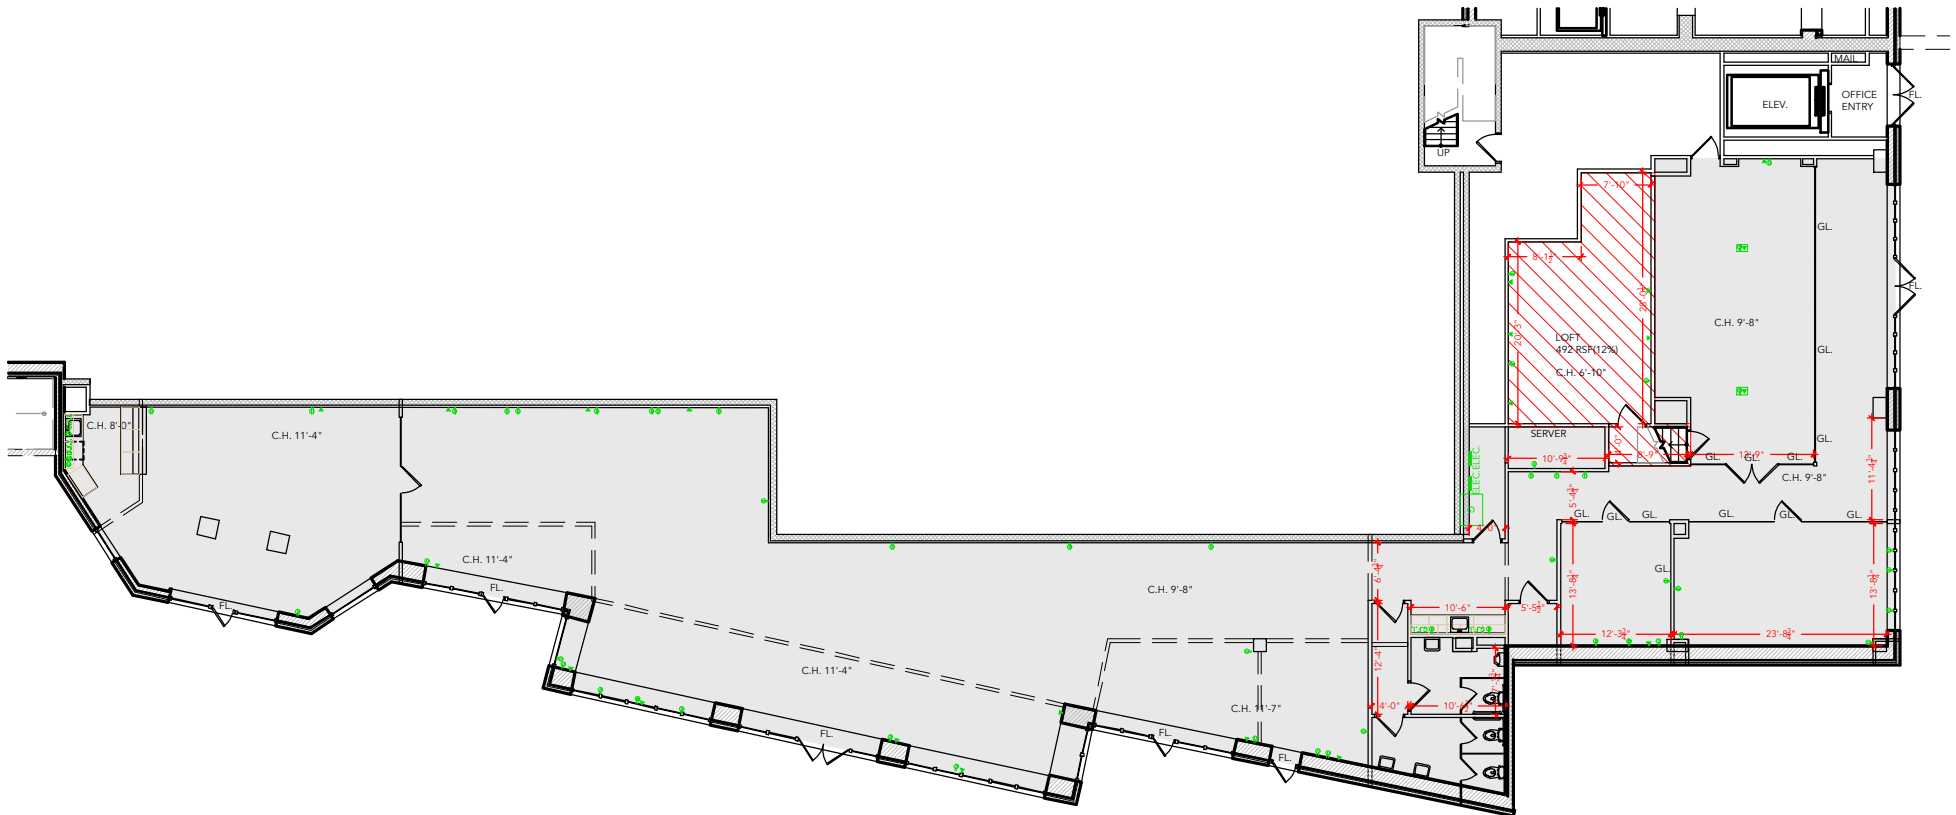

Floor Plan