



TOTAL SF AVAILABLE -2,392 RSF (16%)

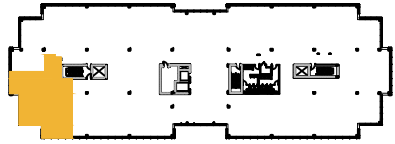

Key Plan

[Click to access 3D model](#)

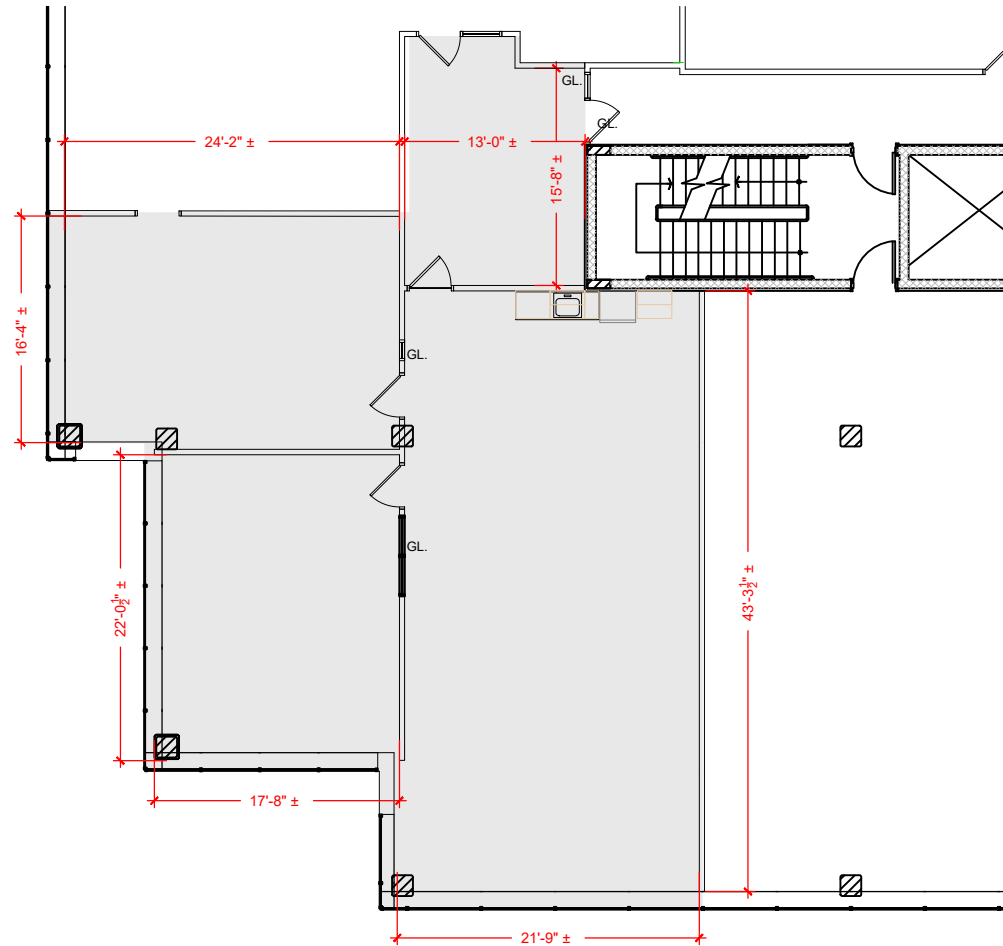

Floor Plan