



TOTAL SF AVAILABLE - 8,185 SF

OFFICE - 2,521 SF
WAREHOUSE - 5,664 SF

[Click to access 3D model](#)

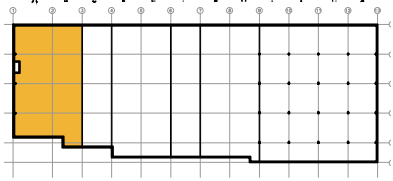

Key Plan

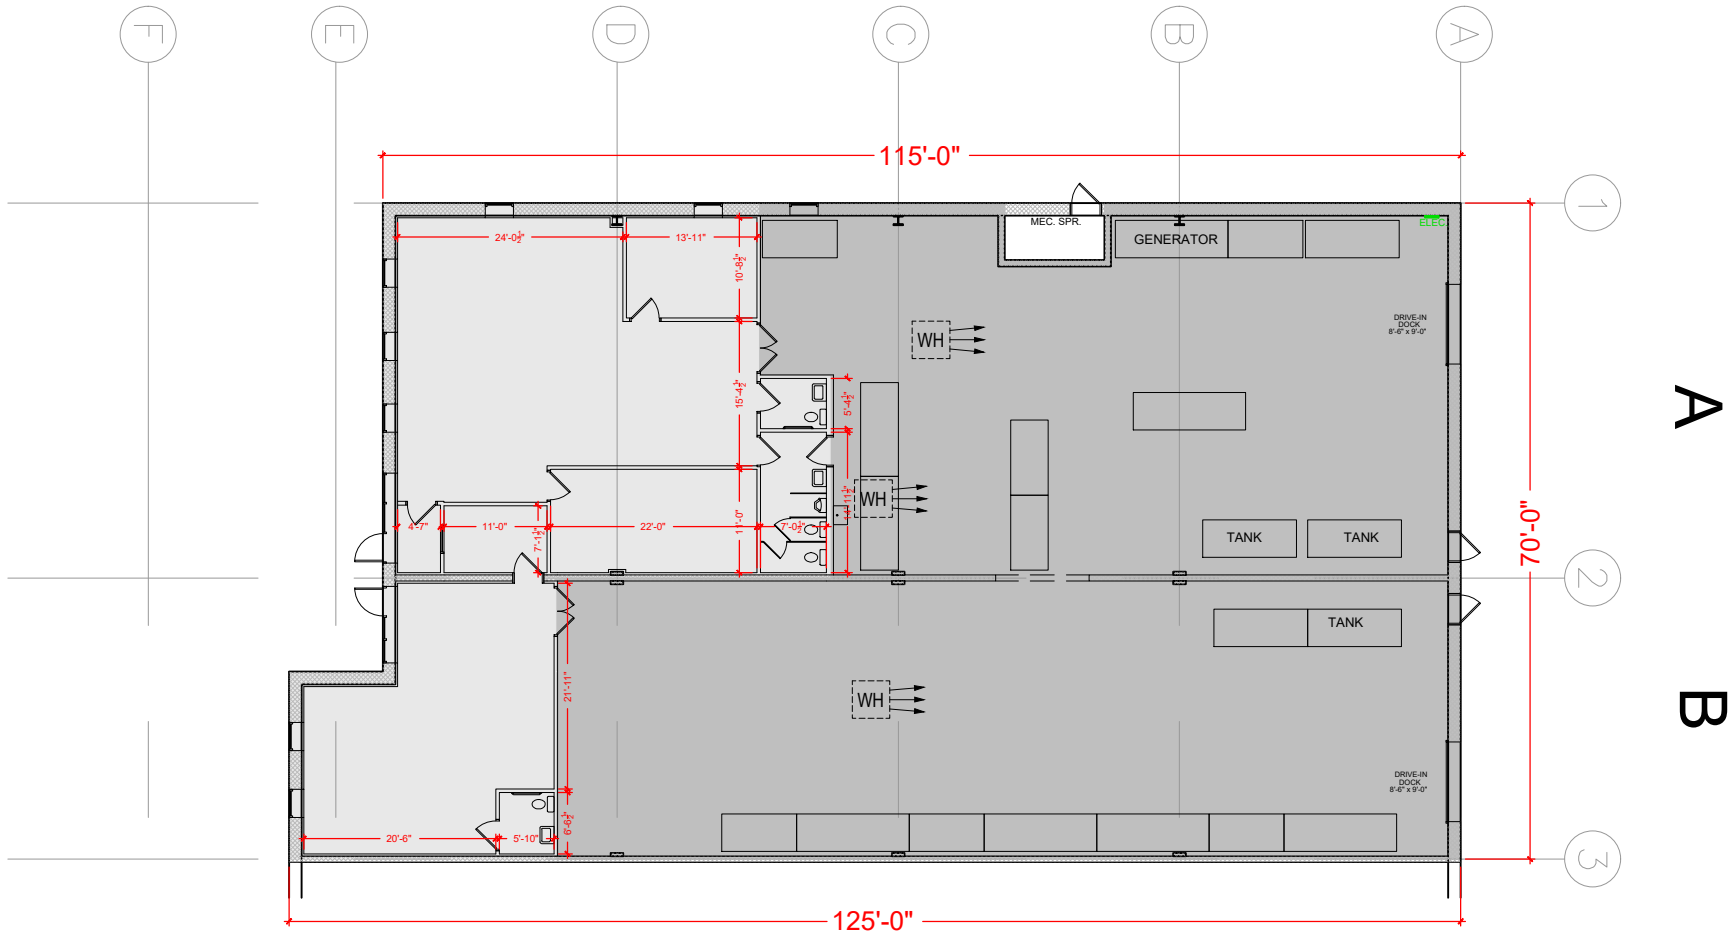

Floor Plan