



**TOTAL SF AVAILABLE - 22,757 SF**

OFFICE - 9,268 SF  
WAREHOUSE - 13,489 SF

[Click to access 3D model](#)

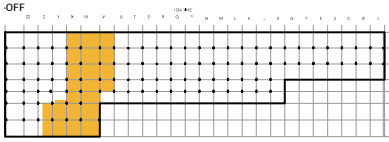

Key Plan

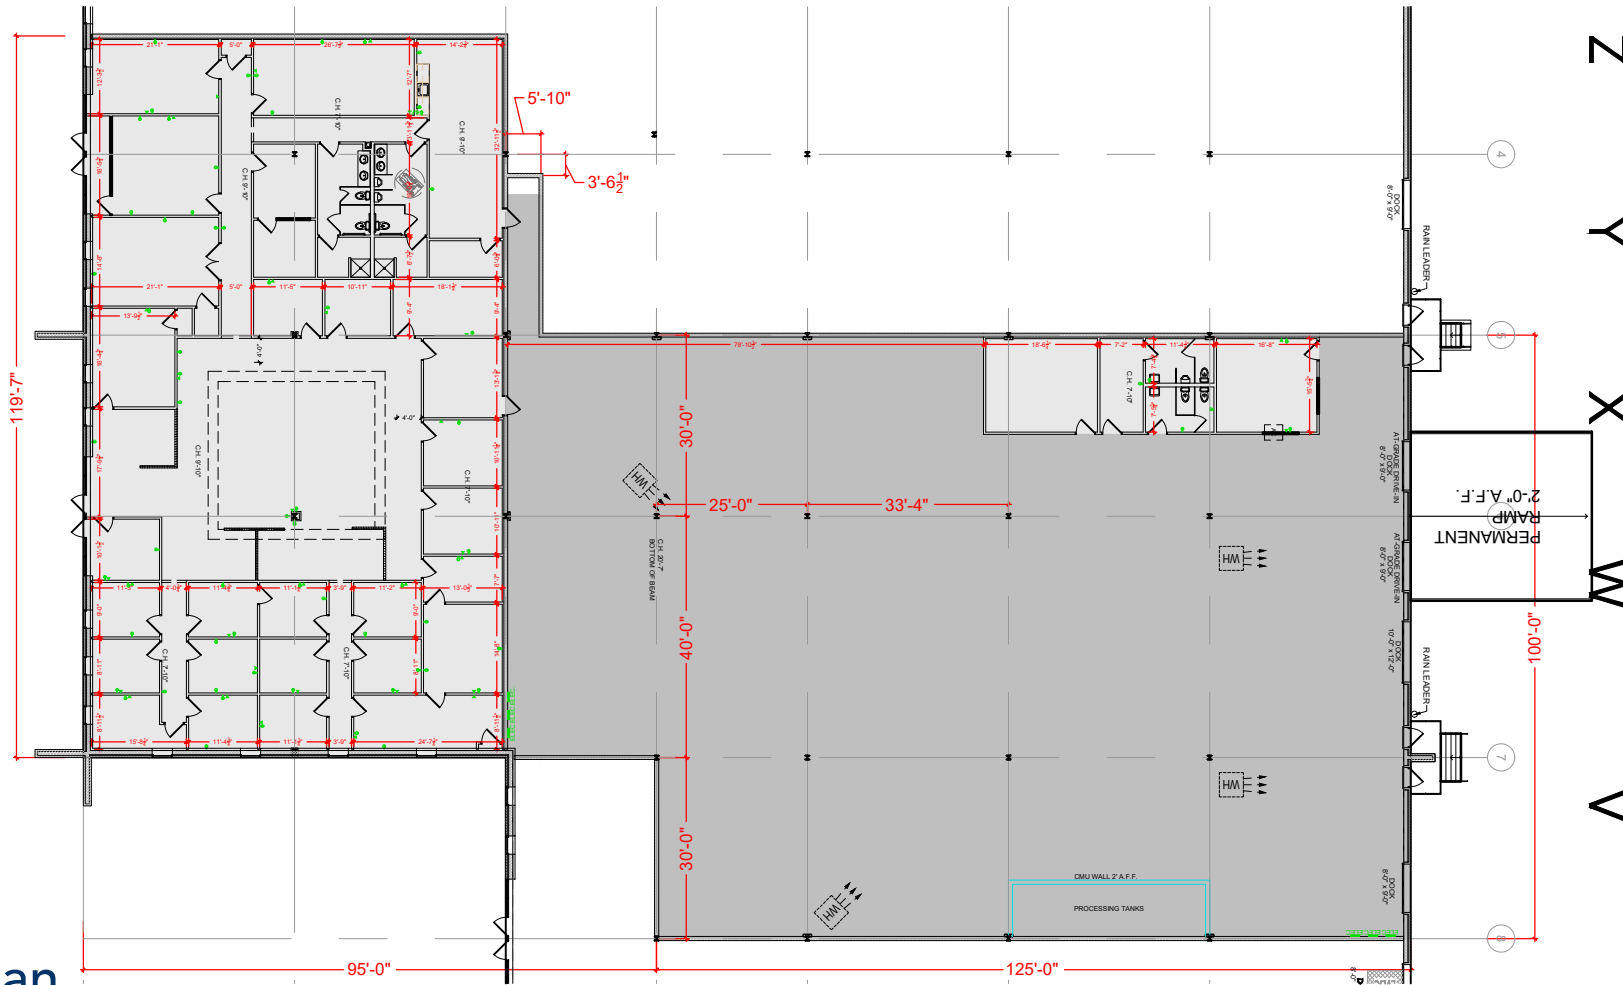

Floor Plan