



TOTAL SF AVAILABLE -3,077 RSF (12%)

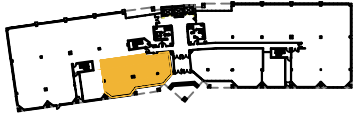

[Click to access 3D model](#)

Key Plan

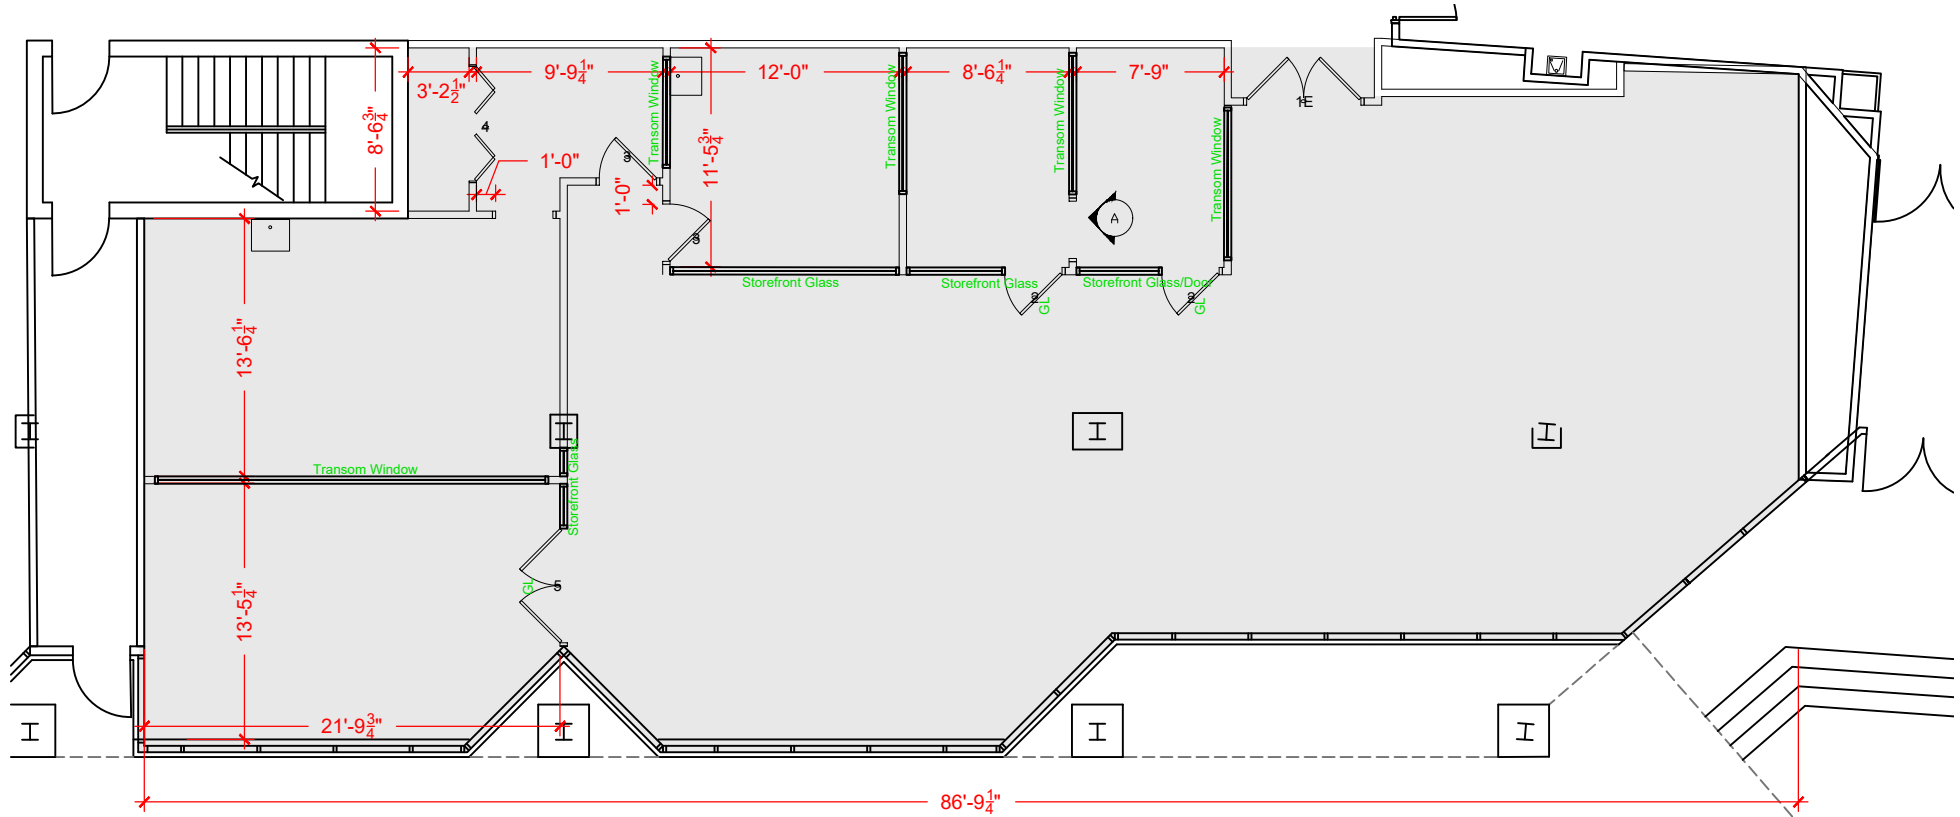

Floor Plan