


TOTAL SF AVAILABLE -1,742 RSF (12%)

[Click to access 3D model](#)

Key Plan

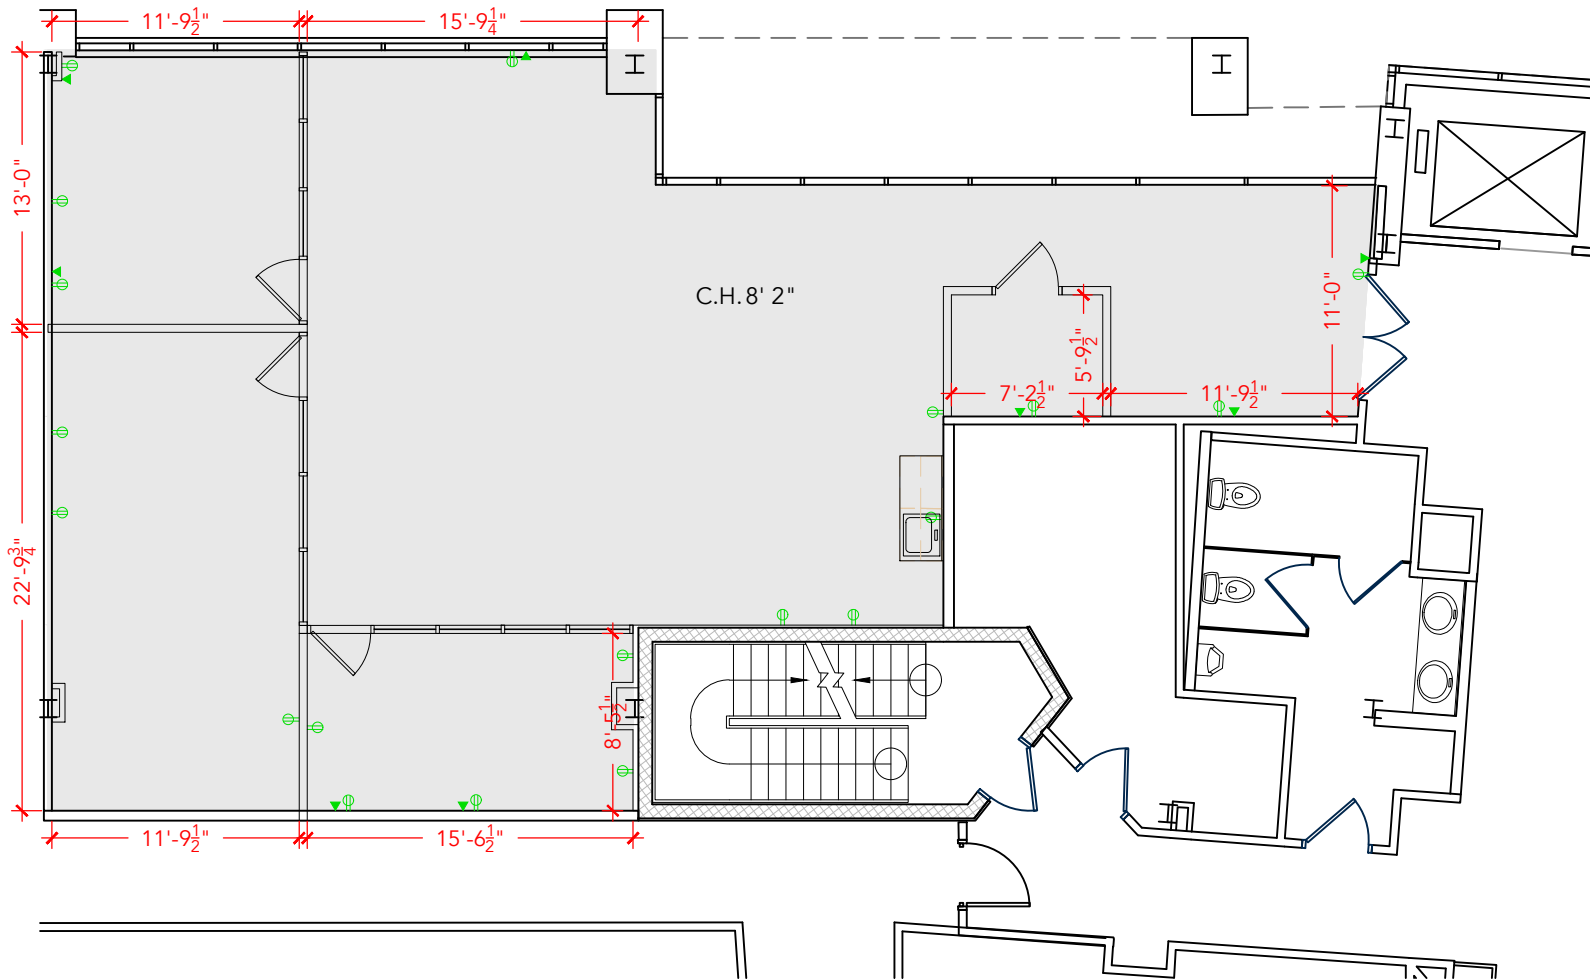

Floor Plan