



TOTAL SF AVAILABLE - 26,372 RSF

OFFICE - 660 RSF

WAREHOUSE - 25,712 RSF

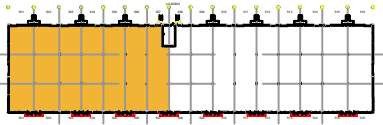

Key Plan

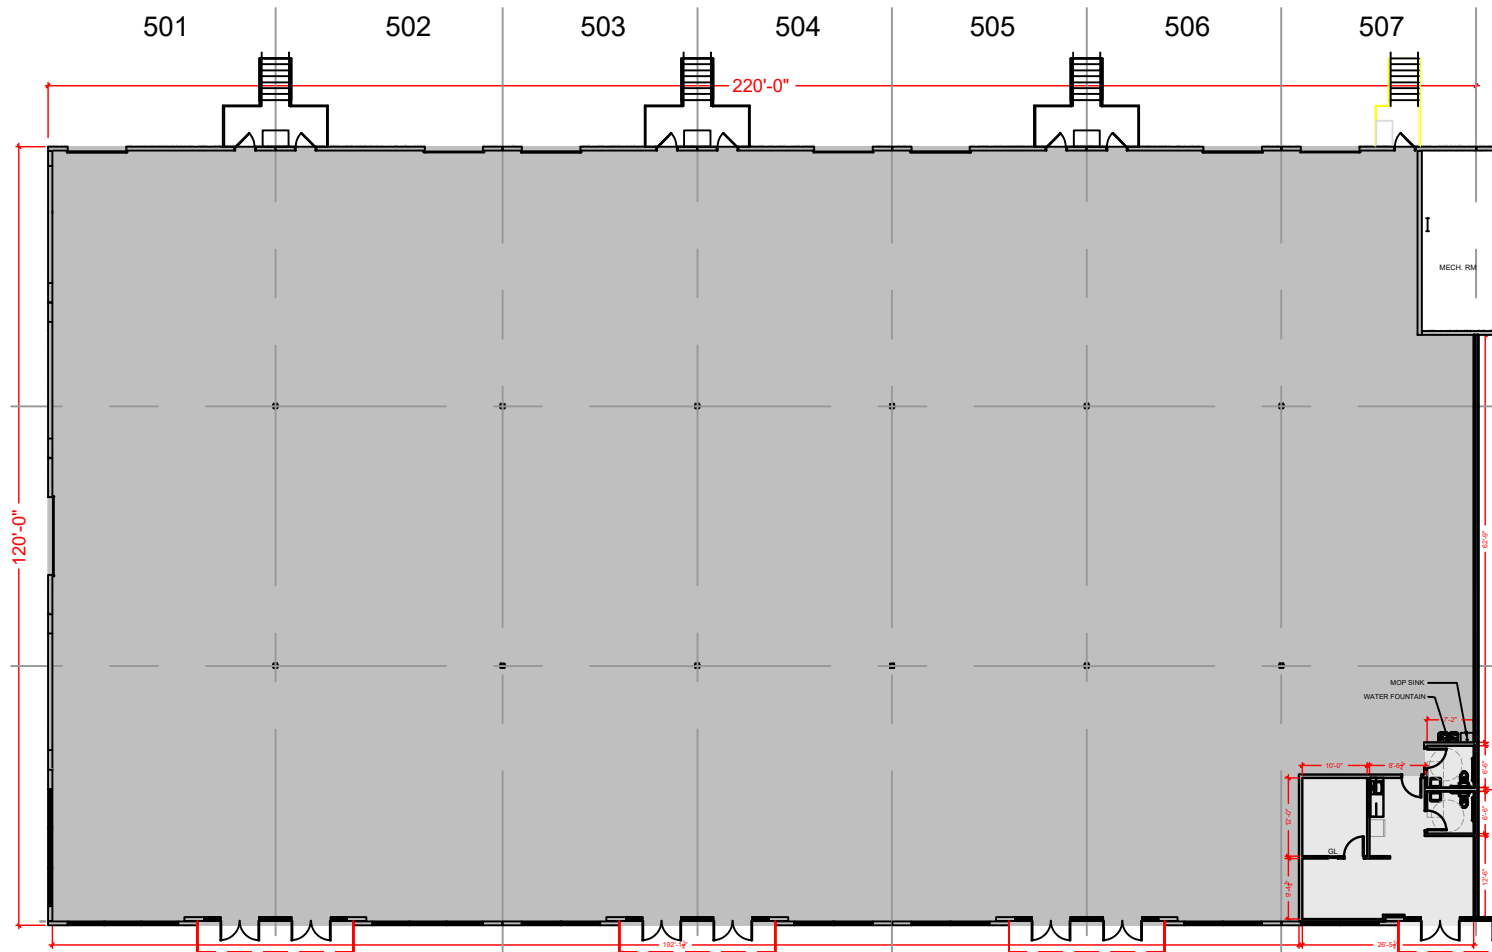

Floor Plan