


TOTAL SF AVAILABLE -9,000 SF


OFFICE - 2,248 SF

WAREHOUSE - 6,752 SF

[Click to access 3D model](#)

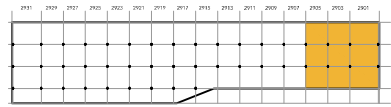

Key Plan

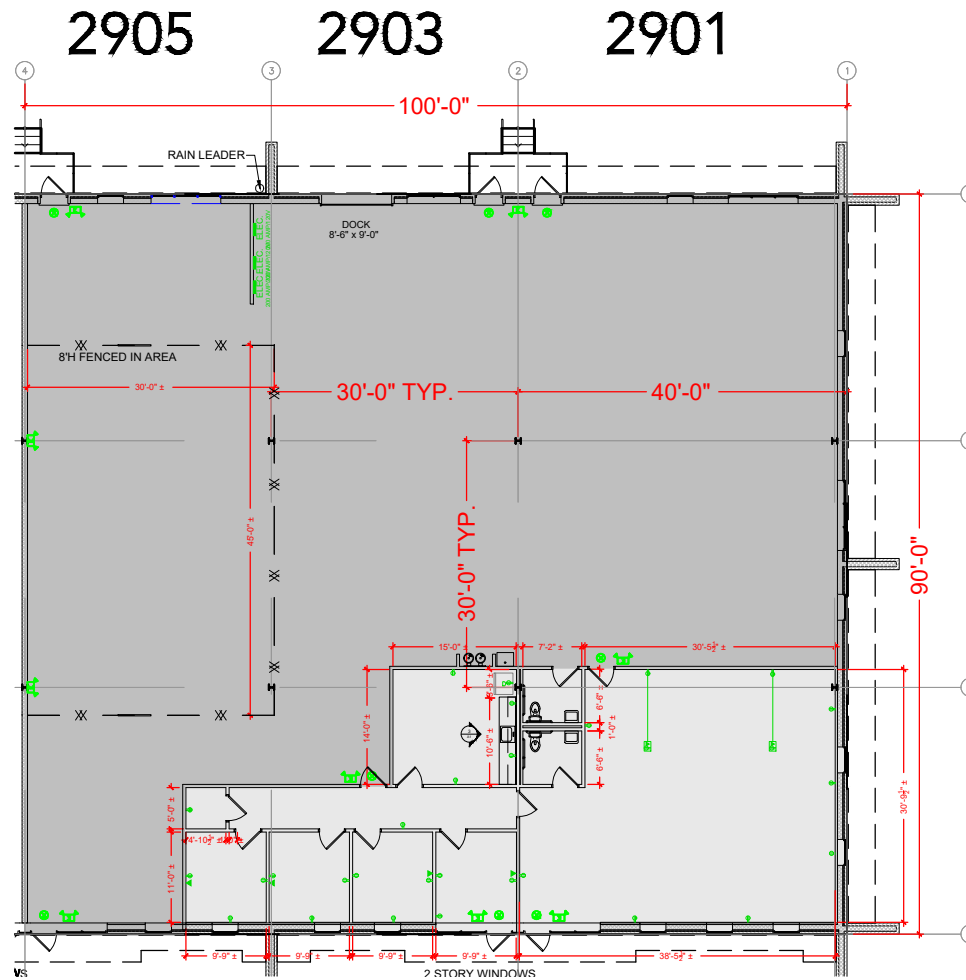

Floor Plan