


TOTAL SF AVAILABLE - 13,976 SF


OFFICE - 13,349 SF

WAREHOUSE - 627 SF

[Click to access 3D model](#)

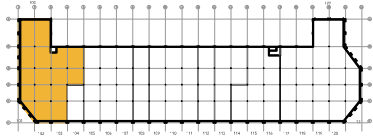

Key Plan

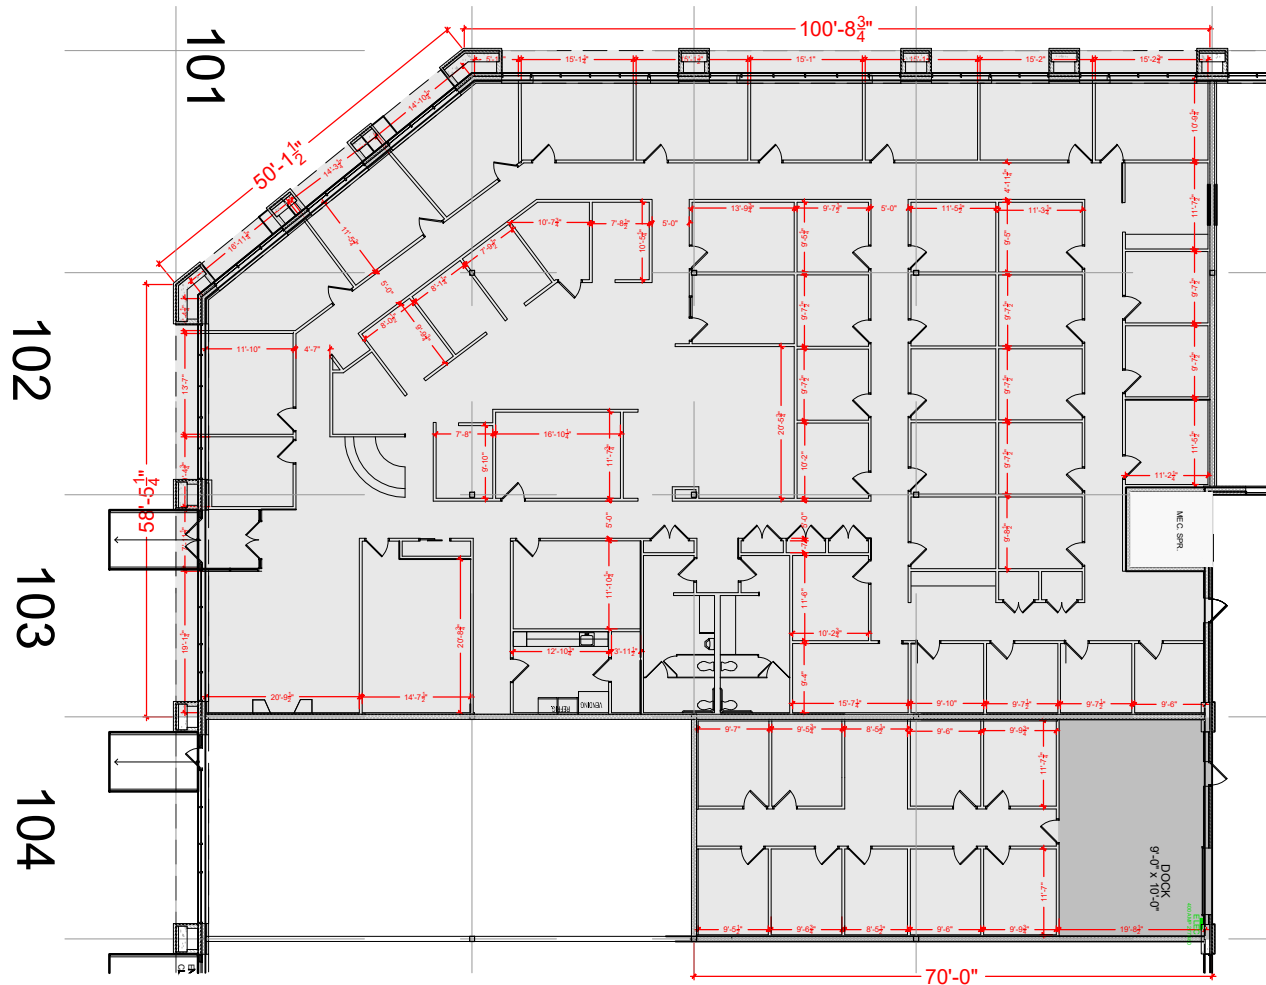

Floor Plan