


TOTAL SF AVAILABLE -2,010 SF

OFFICE - 2,010 SF


WAREHOUSE - 0,000 SF

[Click to access 3D model](#)

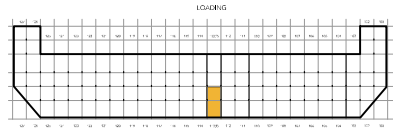

Key Plan

113(F)

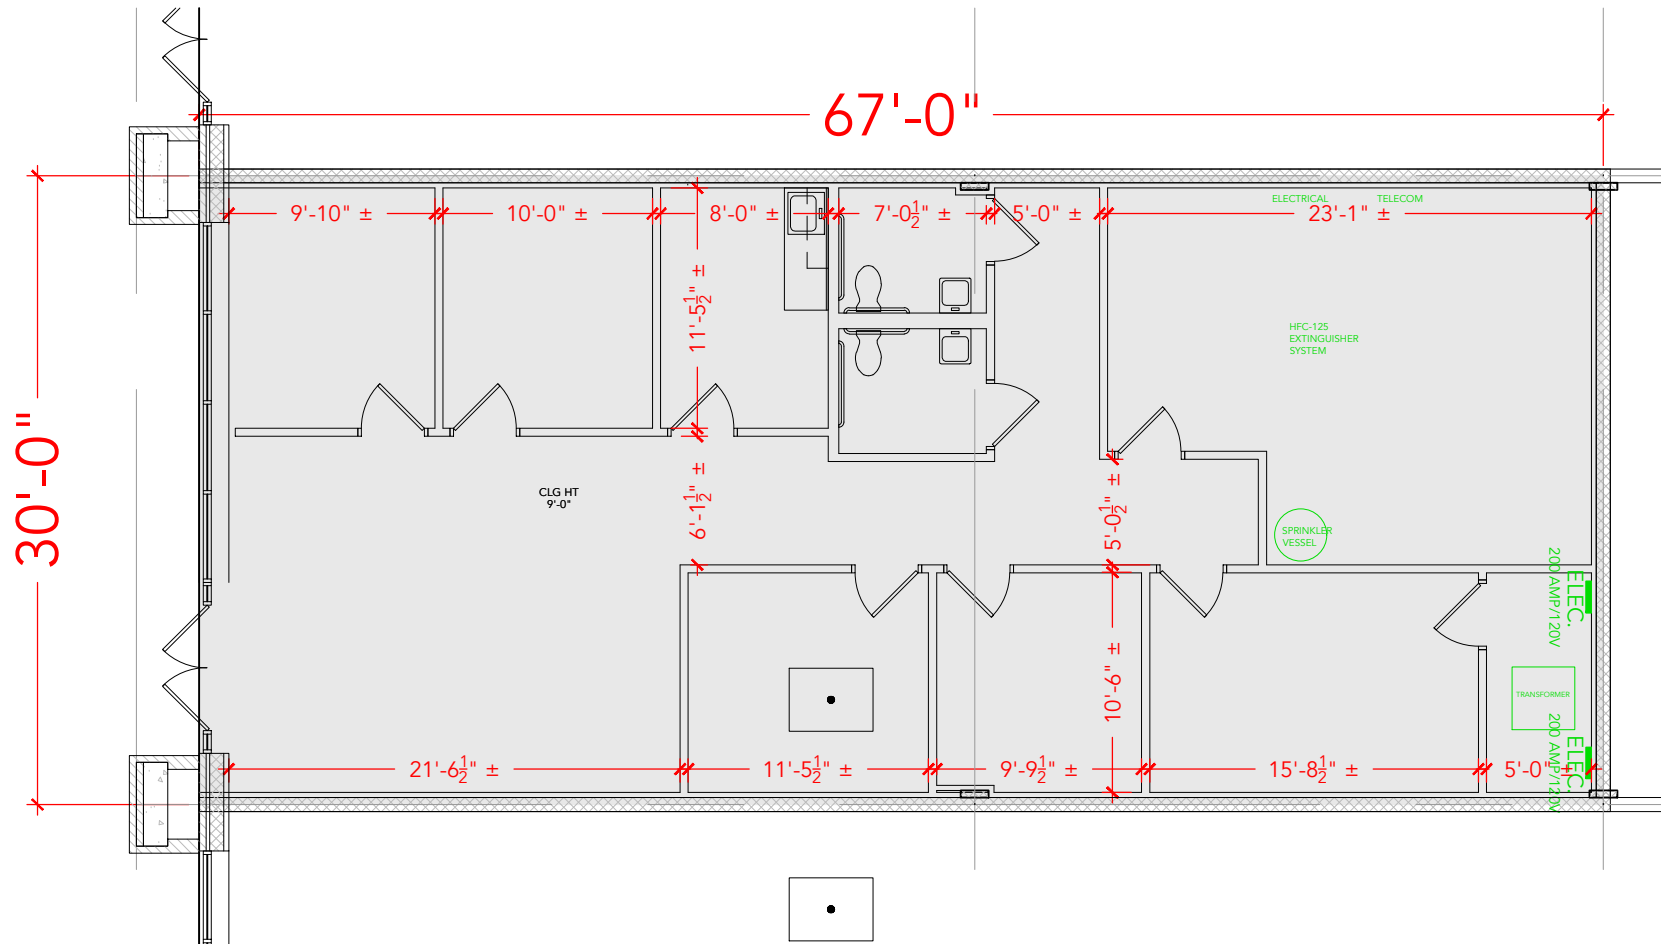

Floor Plan