


TOTAL SF AVAILABLE -2,610 SF


OFFICE - 1,008 SF

WAREHOUSE - 1,602 SF

[Click to access 3D model](#)

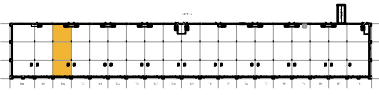

Key Plan

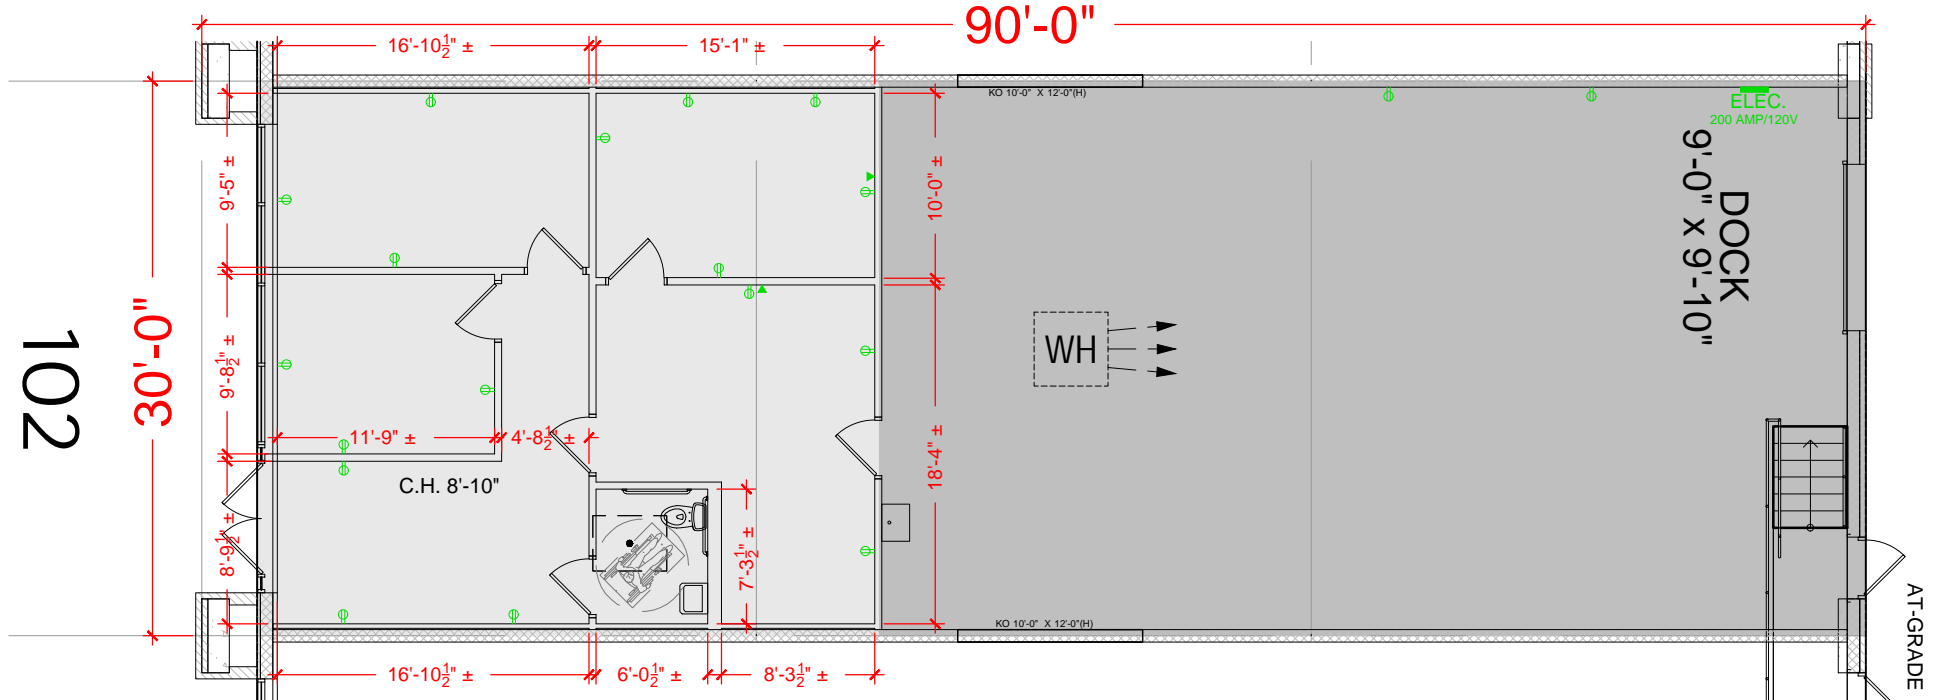

Floor Plan