


**TOTAL SF AVAILABLE - 5,715 SF**


OFFICE - 1,009 SF

WAREHOUSE SF - 4,706 SF

[Click to access 3D model](#)

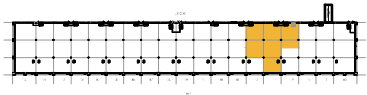

Key Plan

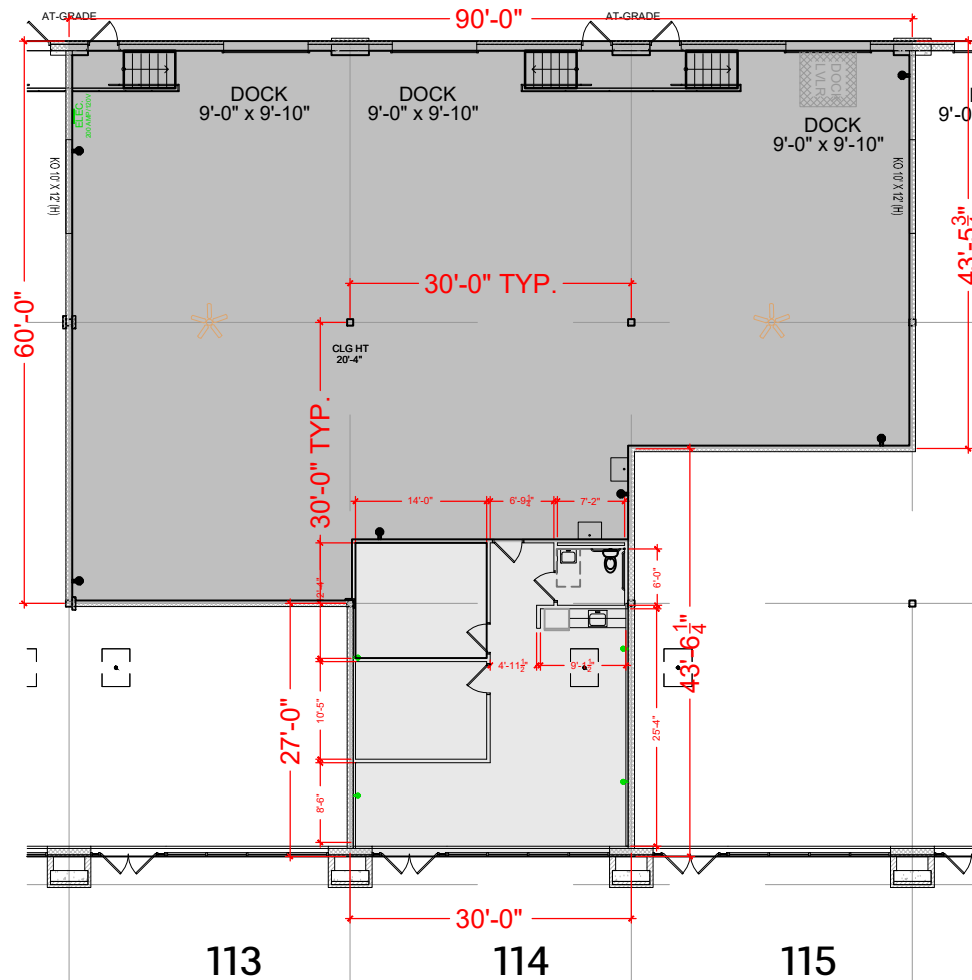

Floor Plan