



TOTAL SF AVAILABLE - 3,750 SF

OFFICE - 1,231 SF
WAREHOUSE - 2,519 SF

[Click to access 3D model](#)

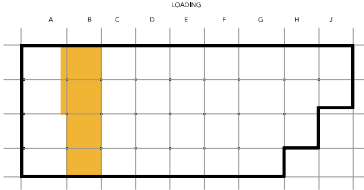

Key Plan

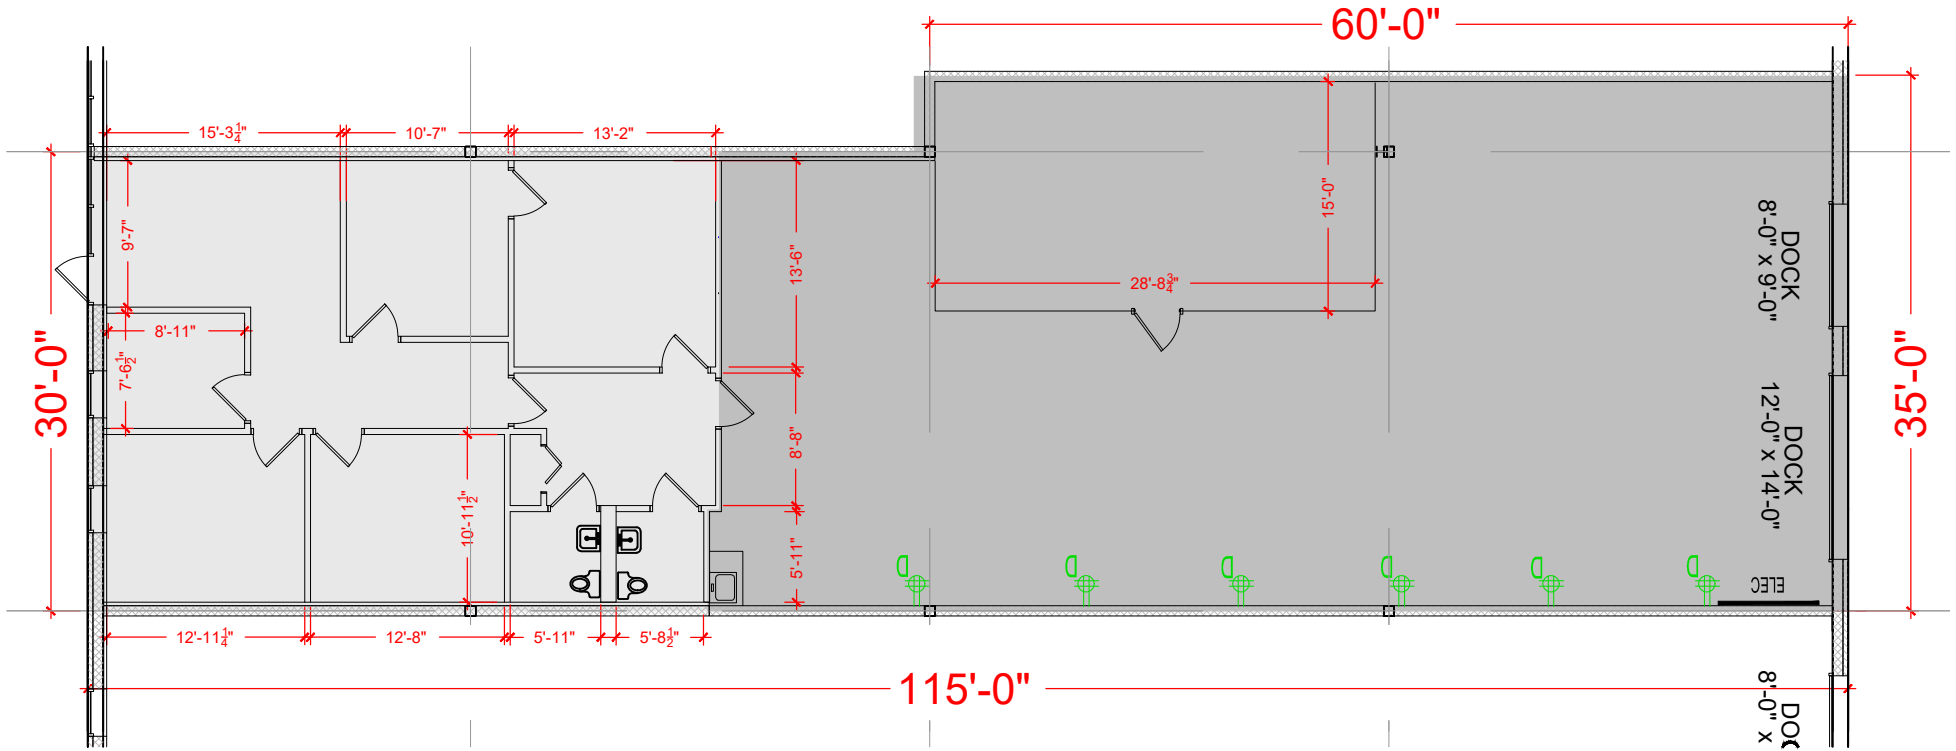

Floor Plan