


TOTAL SF AVAILABLE - 3,600 SF


OFFICE - 2,623 SF

WAREHOUSE - 977 SF

[Click to access 3D model](#)

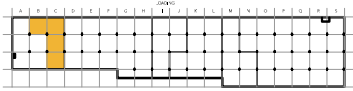

Key Plan

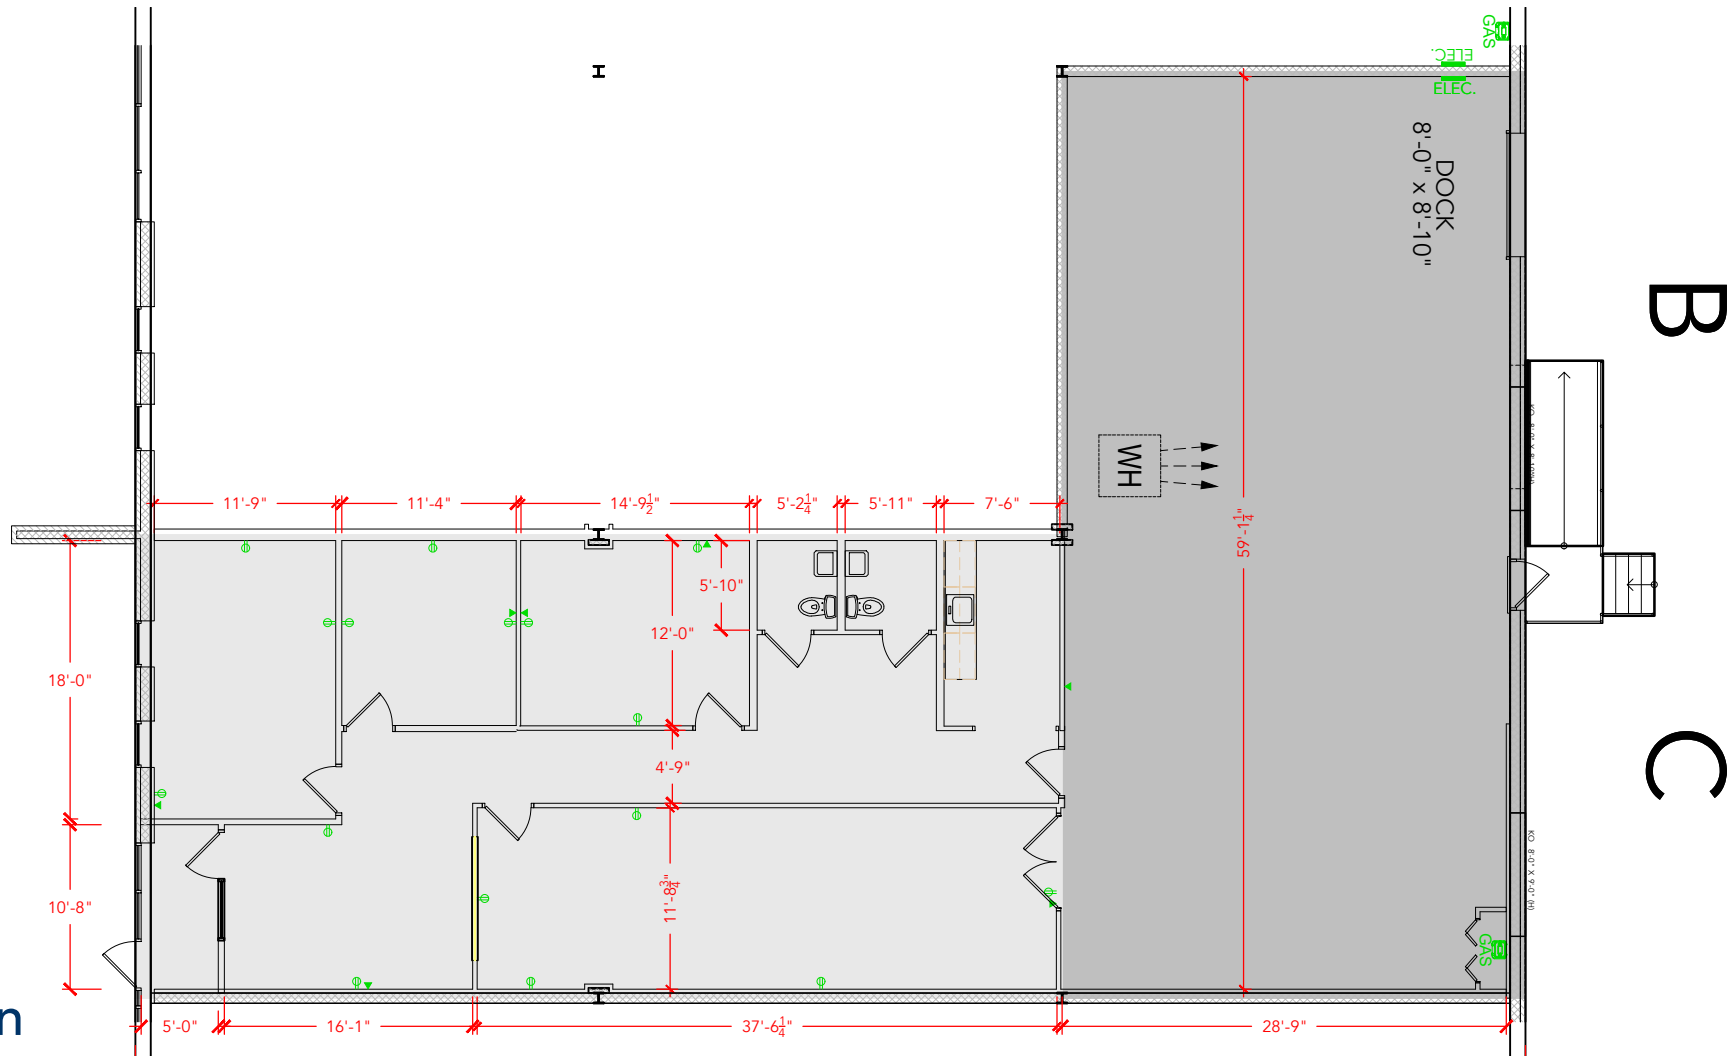

Floor Plan