
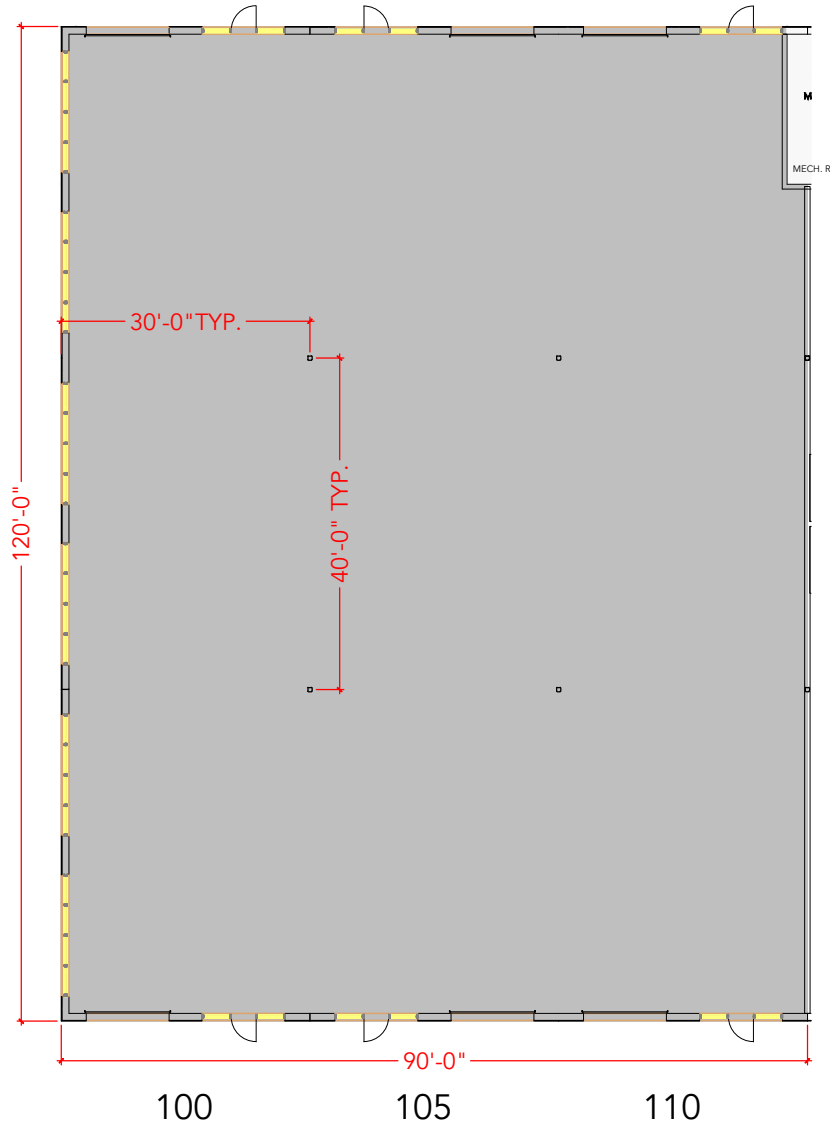


TOTAL SF AVAILABLE - 10,819 RSF

(INCLUDES % OF MECH. RM)

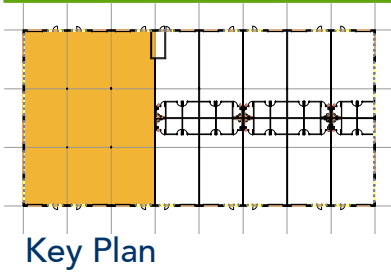

Floor Plan