


**TOTAL SF AVAILABLE - 28,583 RSF**


**OFFICE - 0,000 SF**

**WAREHOUSE - 28,583 RSF**

\* INCLUDES % OF METER ROOM  
[Click to access 3D model](#)

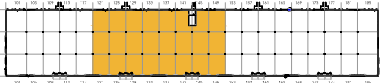

Key Plan

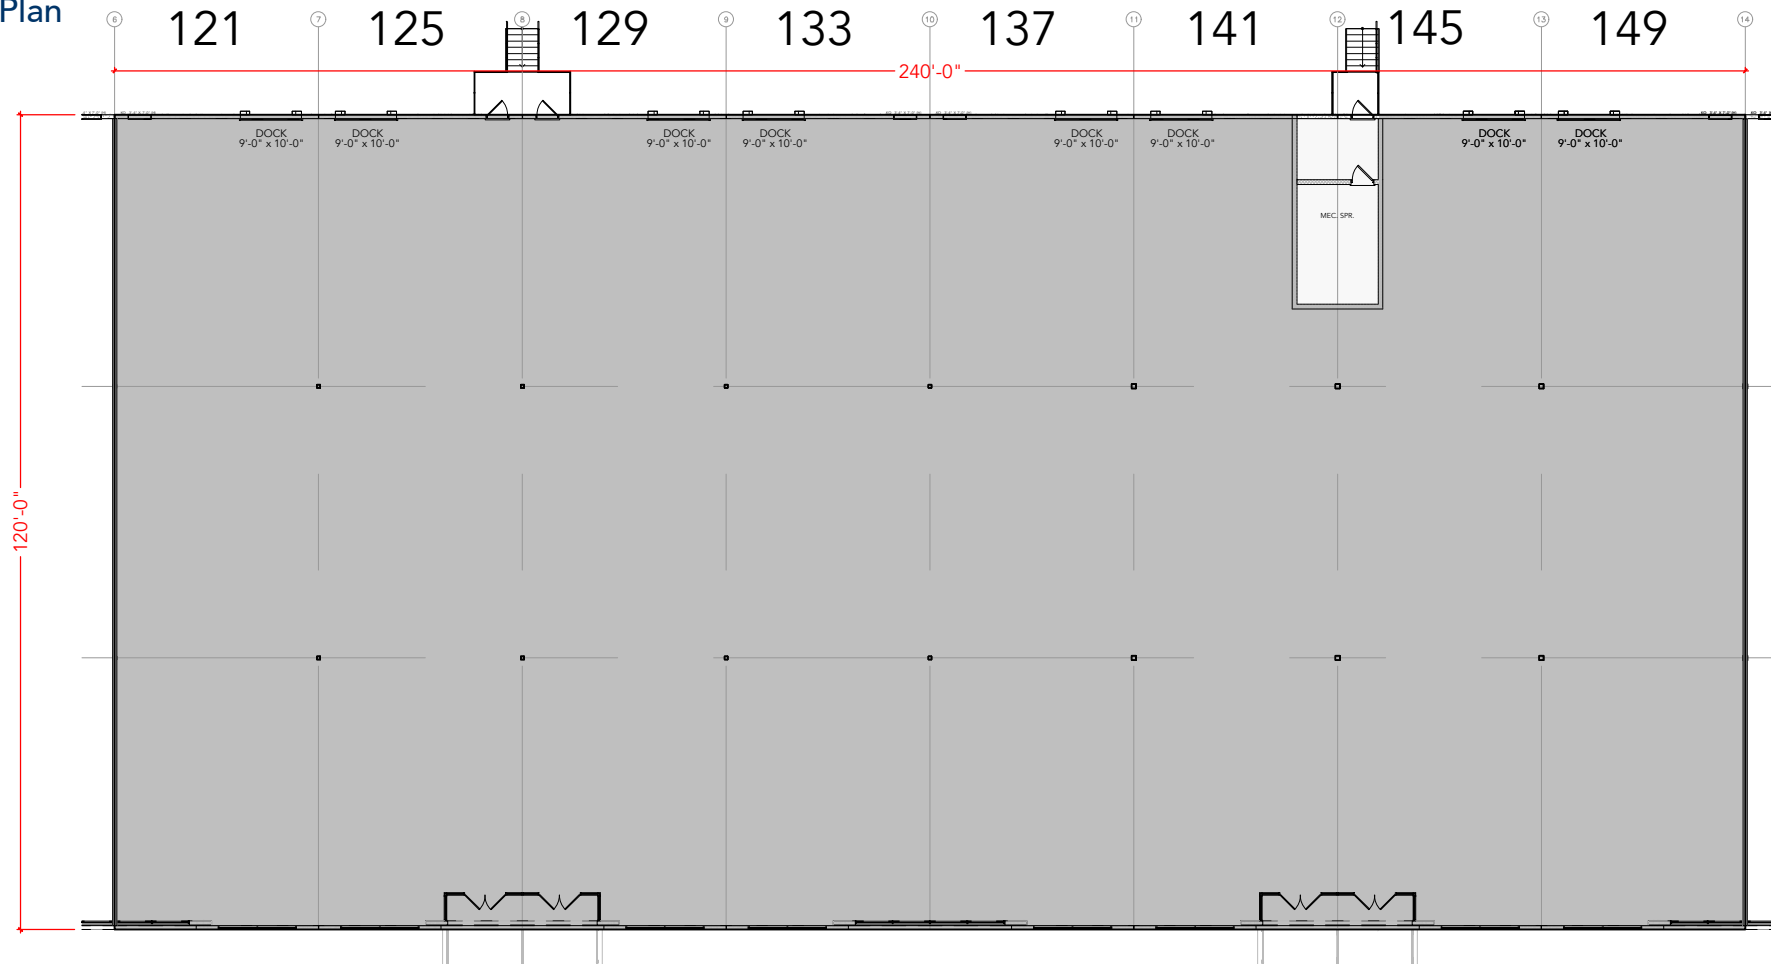

Floor Plan