



TOTAL SF AVAILABLE - 1,738 RSF(12%)

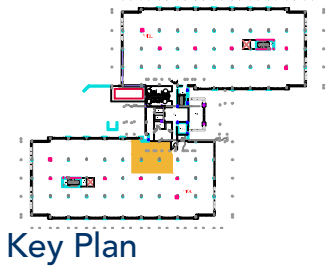

[Click to access 3D model](#)

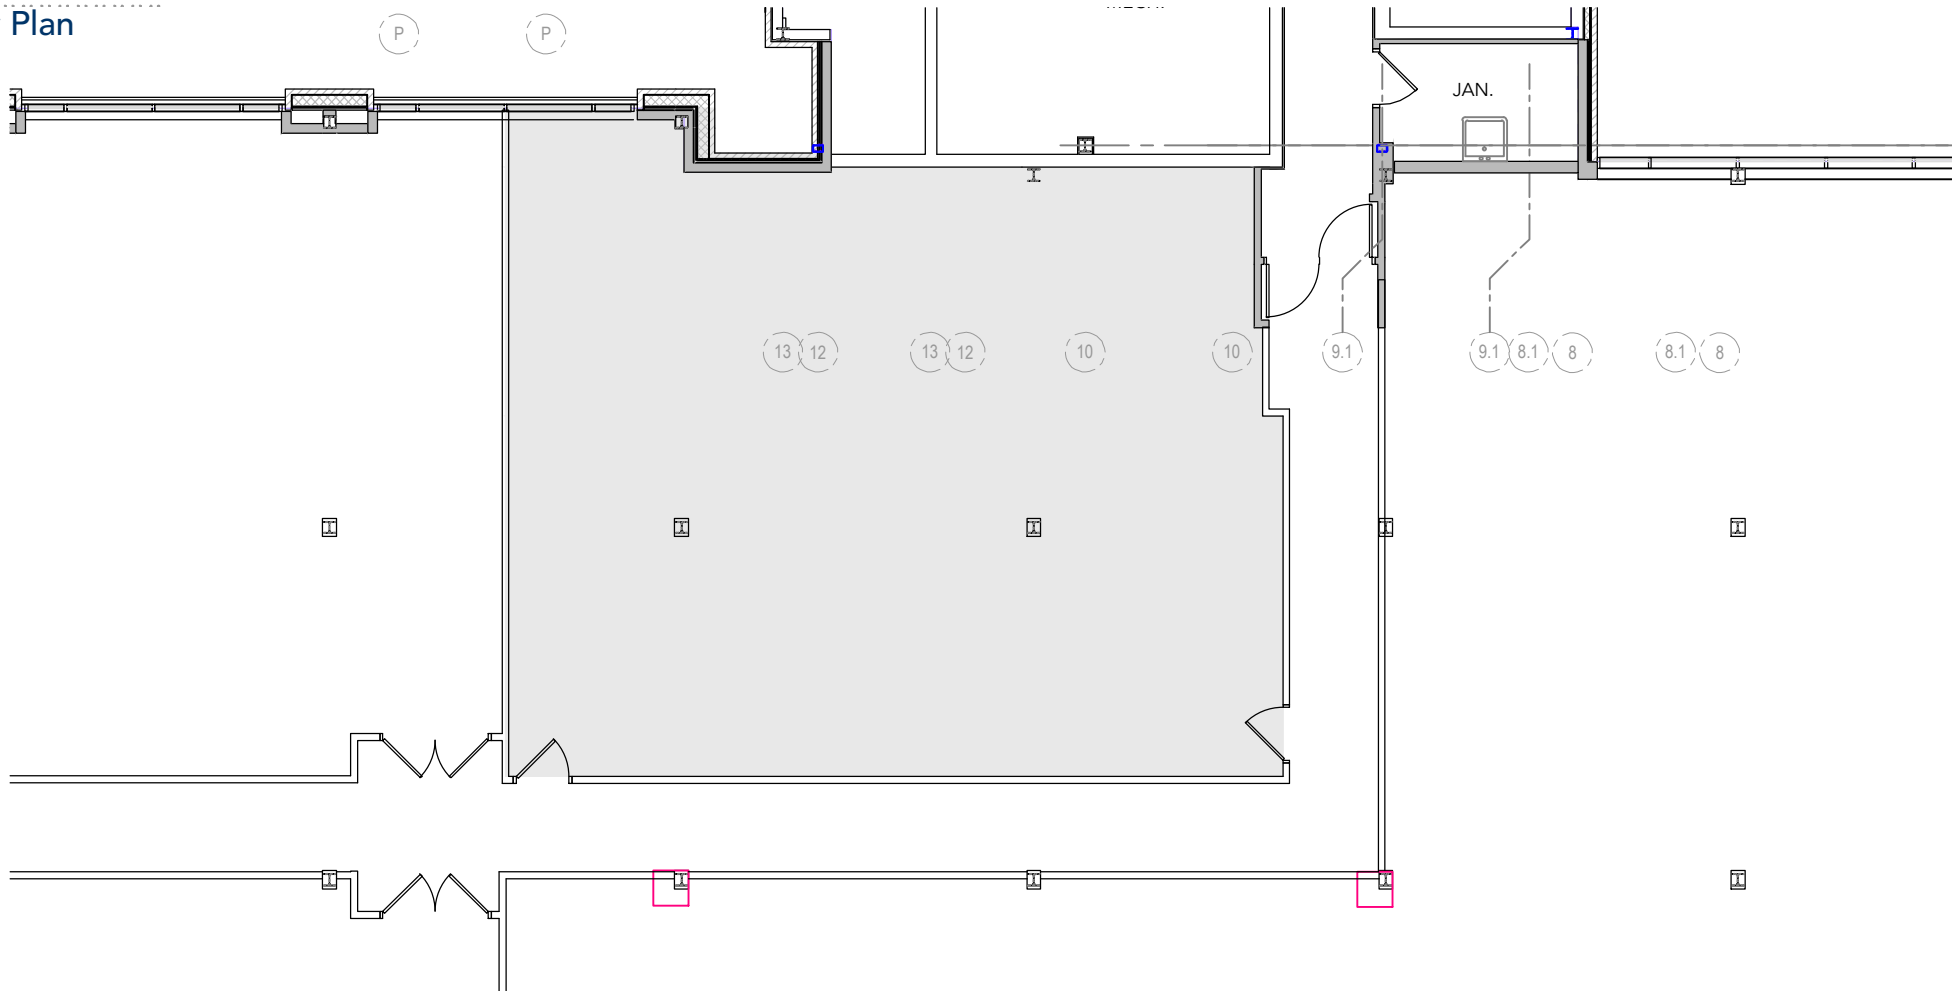

Floor Plan