
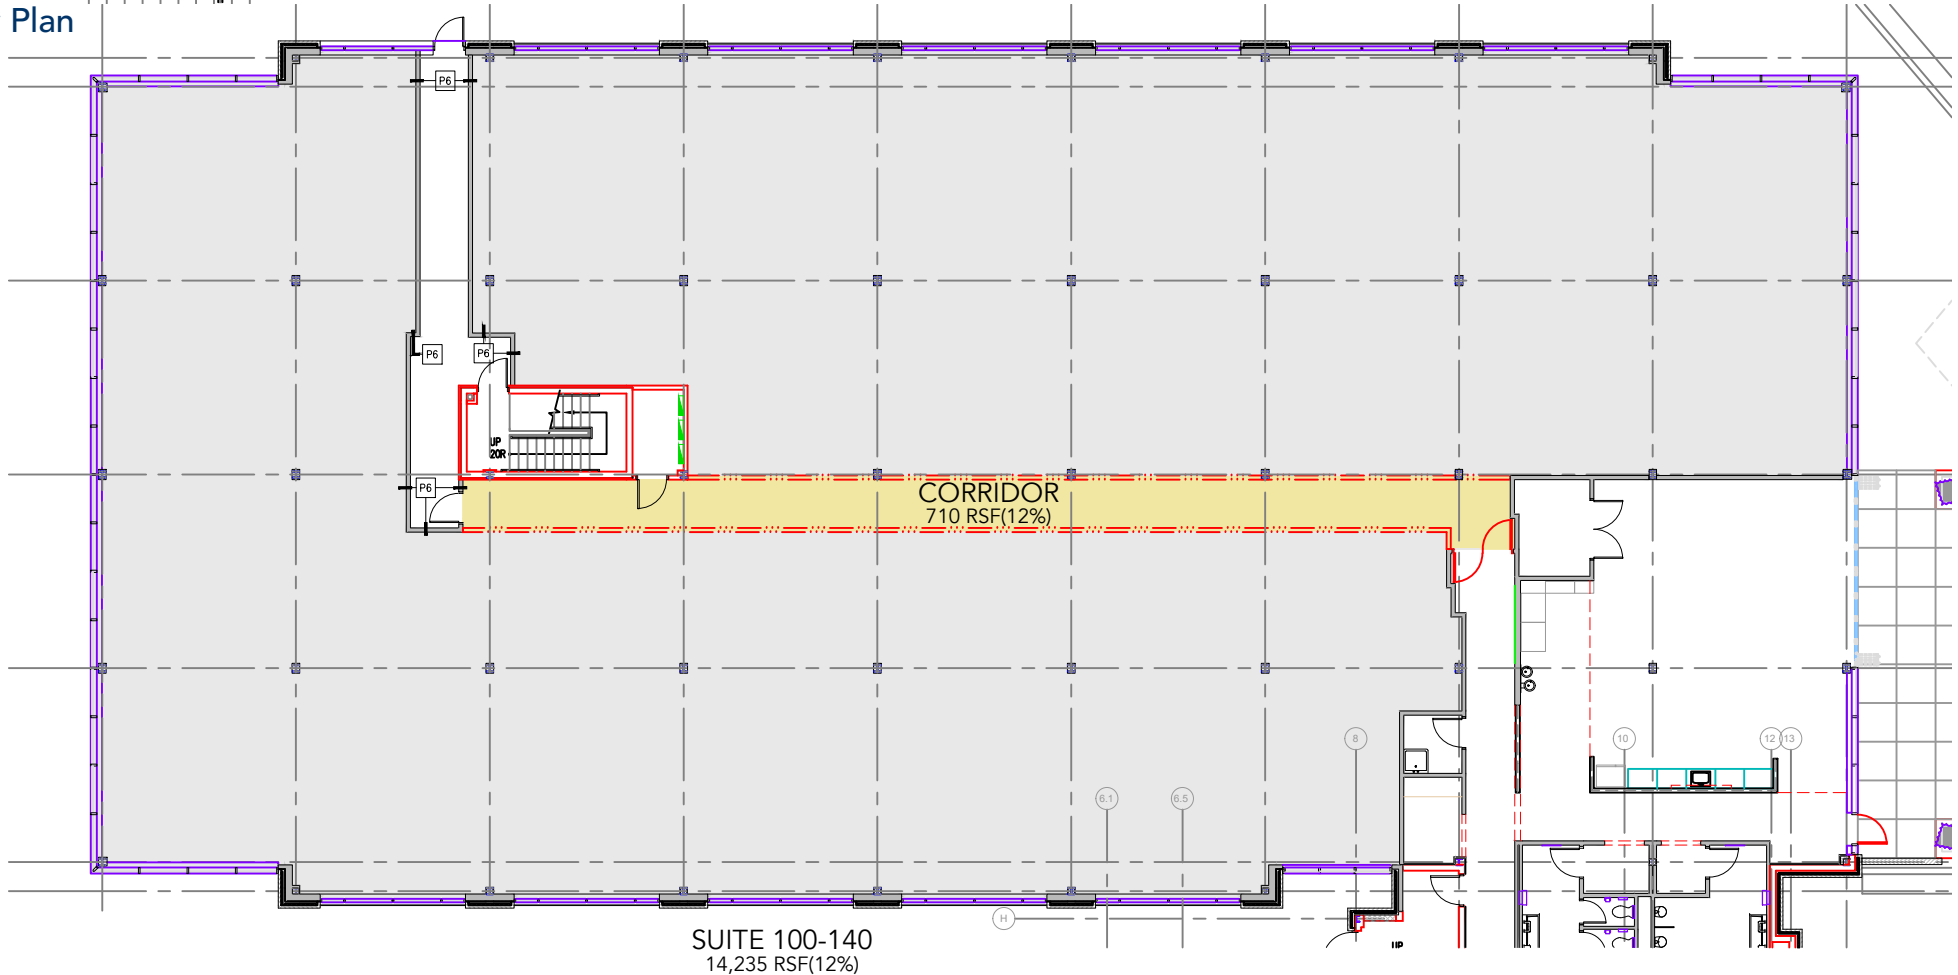


TOTAL SF AVAILABLE - 14,945 RSF(12%)

[Click to access 3D model](#)

Key Plan

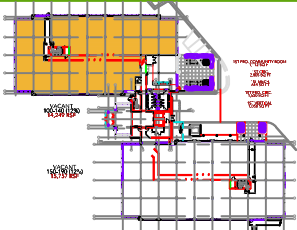

Floor Plan