


TOTAL SF AVAILABLE -22,445 RSF(12%)


SUITE 200-240 - 15,925 RSF(12%)

SUITE 250-265 - 6,520 RSF(12%)

[Click to access 3D model](#)

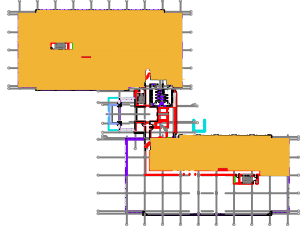

Key Plan

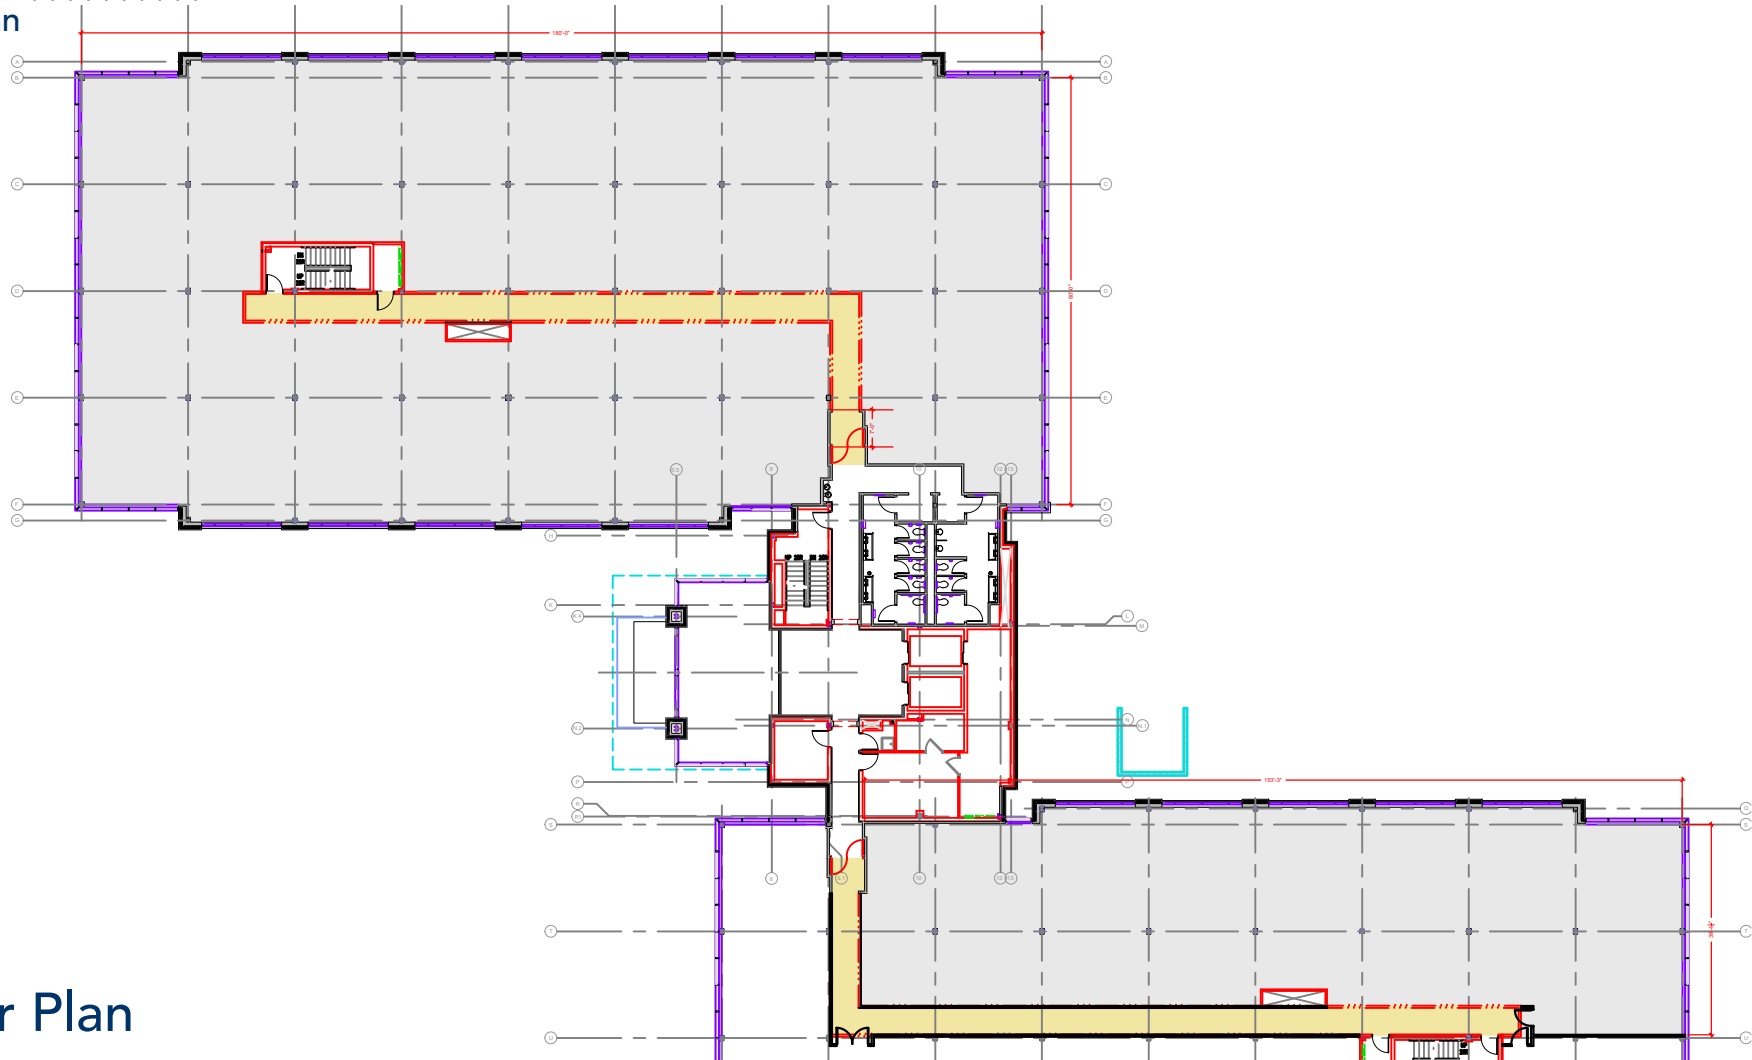

Floor Plan