
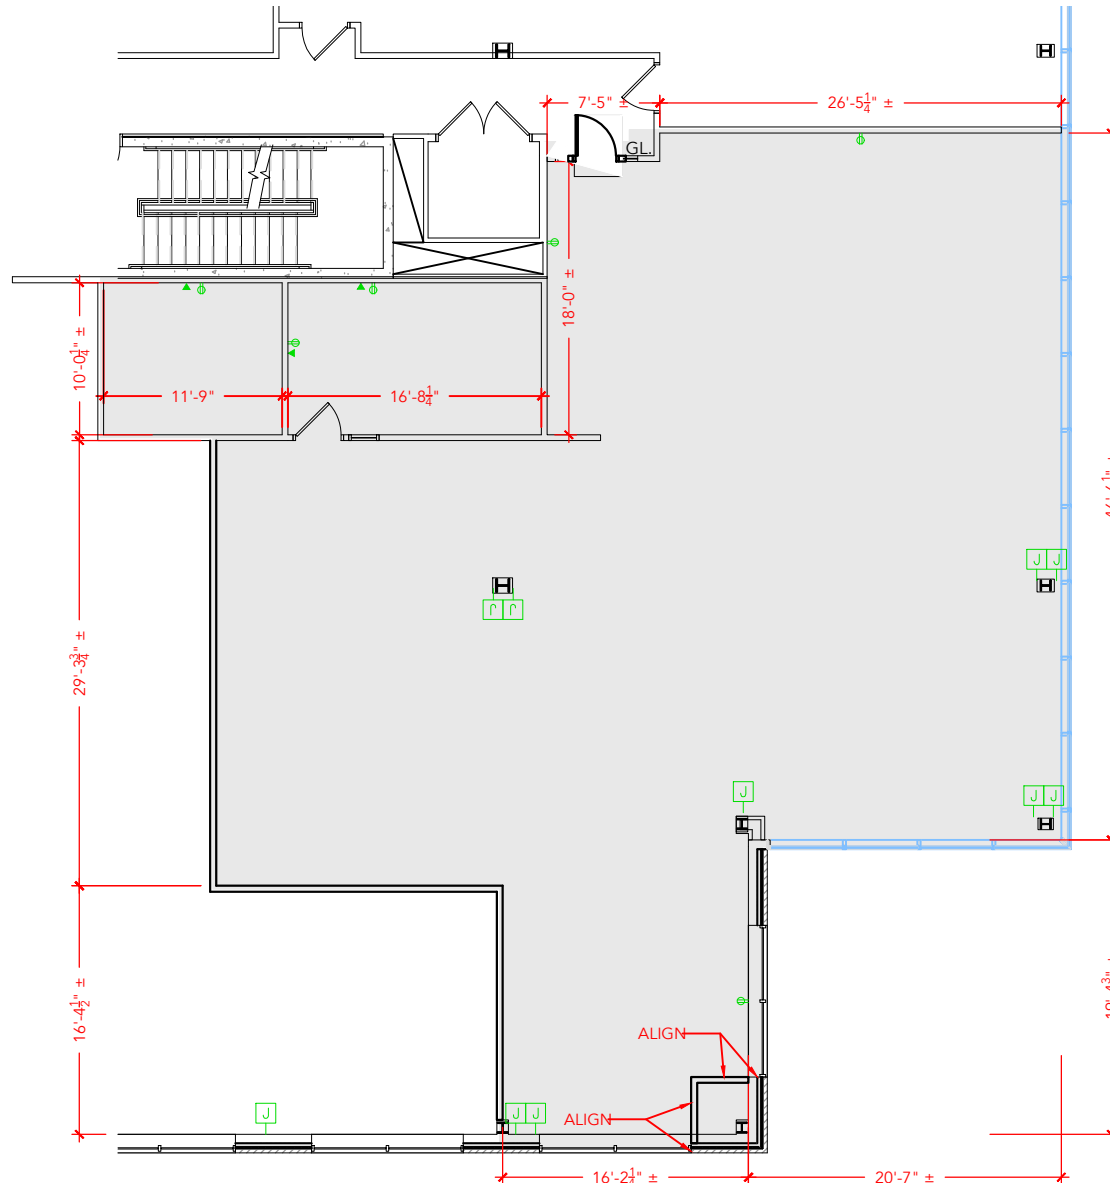


TOTAL SF AVAILABLE - 3,260 RSF(12%)

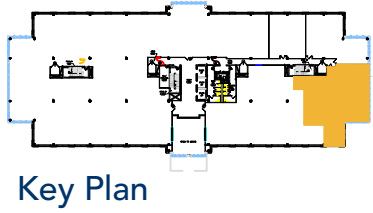

Floor Plan