


TIMONIUM THREE


2026 GREENSPRING DRIVE TIMONIUM, MD 21093
SUITE 300-390

TOTAL SF AVAILABLE - 29,552 RSF(9%)

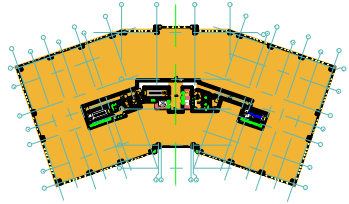

Key Plan

[Click to access 3D model](#)

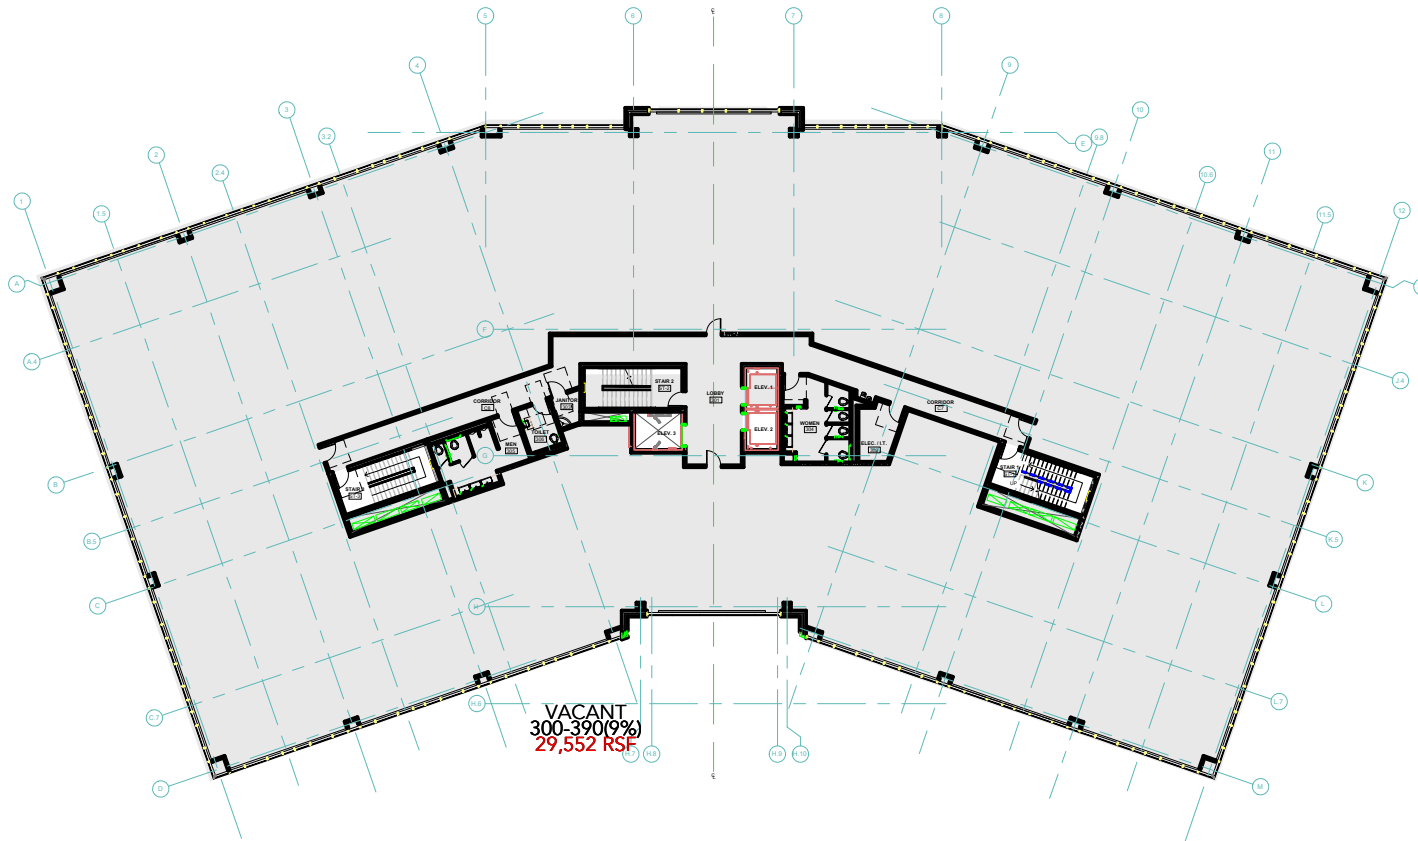

Floor Plan