


TOTAL SF AVAILABLE - 8,974 RSF

OFFICE - 8,974 RSF


WAREHOUSE - 0,000 SF

INCLUDES % OF METER ROOM

[Click to access 3D model](#)

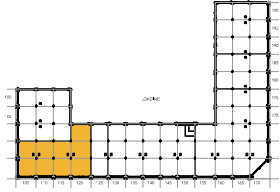

Key Plan

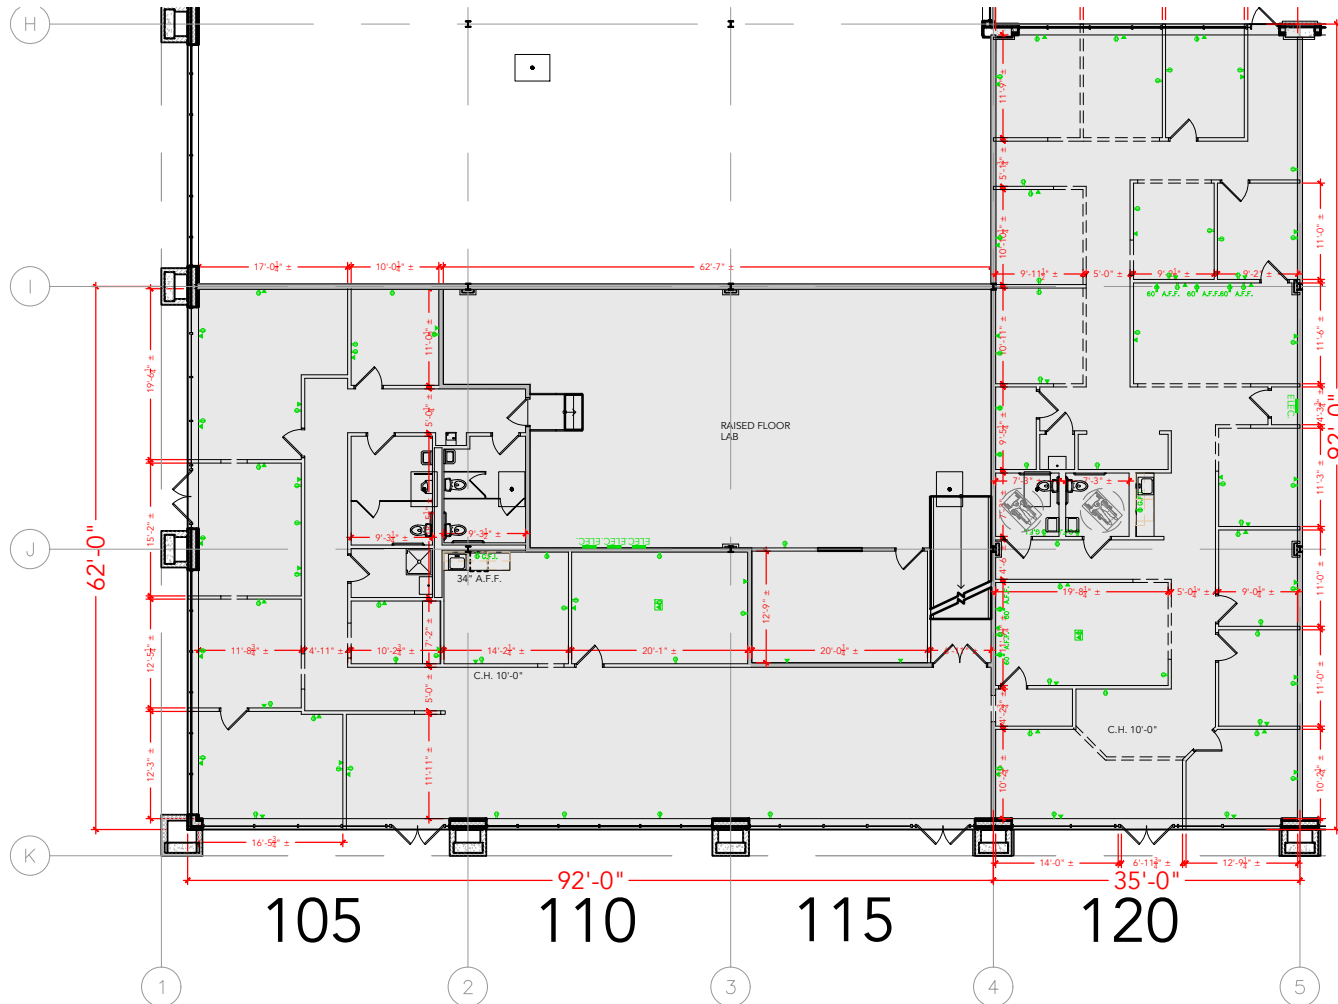

Floor Plan