


TOTAL SF AVAILABLE - 13,295 SF

OFFICE - 2,427 SF



WAREHOUSE - 10,873 SF

* 7,800 SF MEZZ NOT INCLUDED IN TOTAL SQFT

[Click to access 3D model](#)

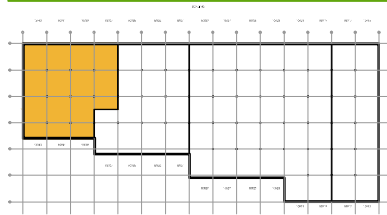

Key Plan

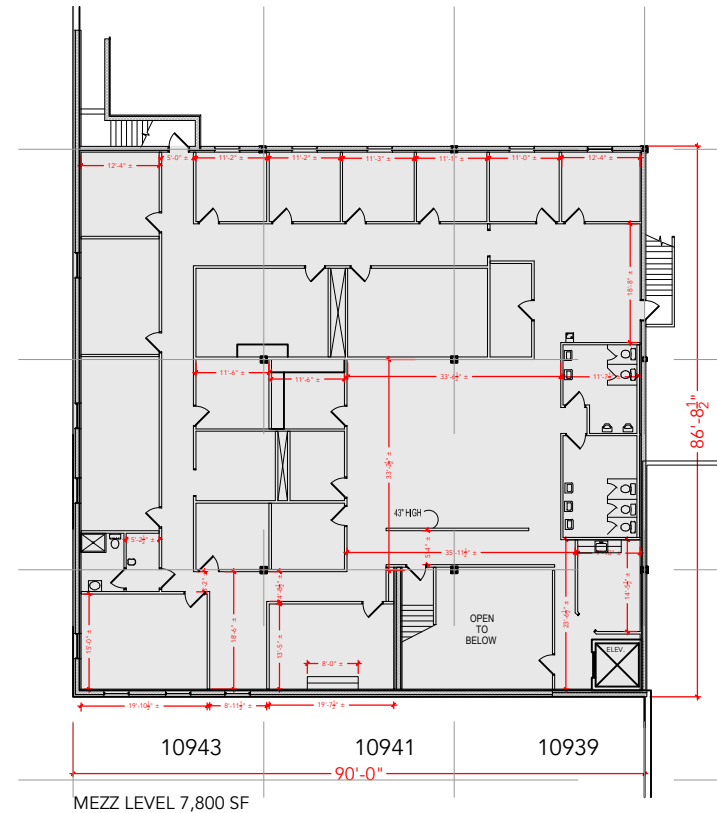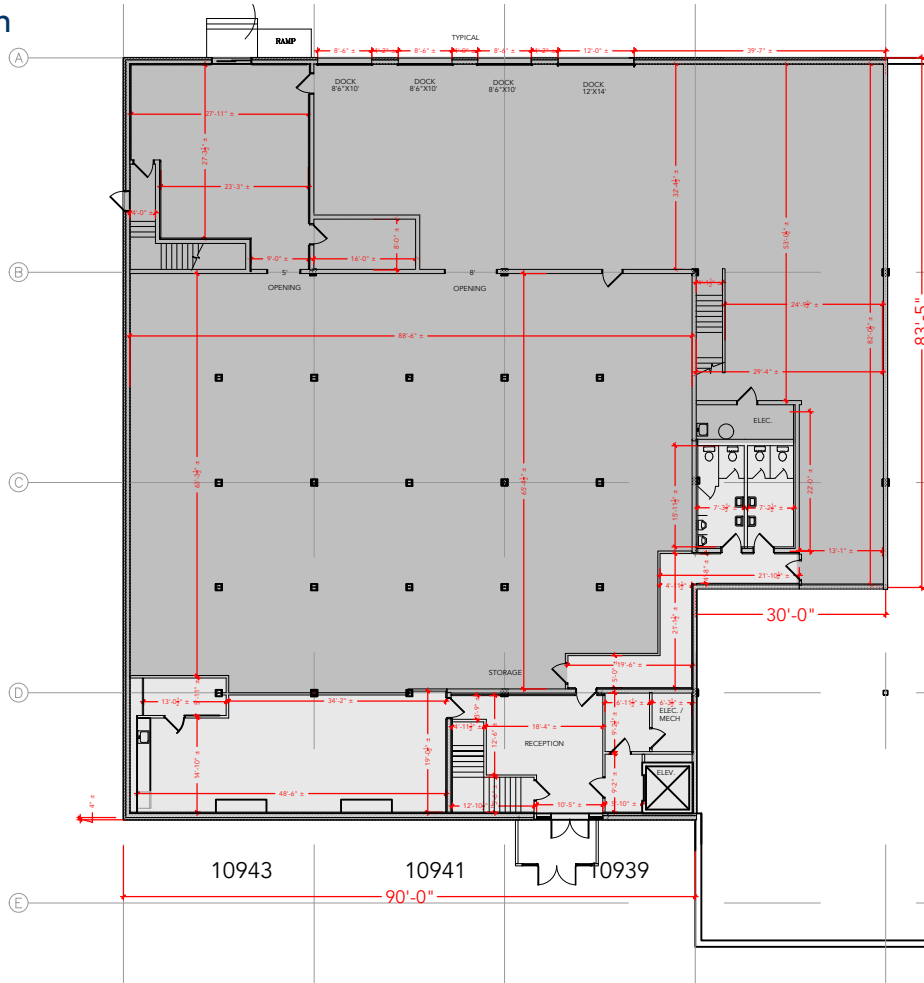

Floor Plan