



TOTAL SF AVAILABLE - 26,554 RSF

(INCLUDES % OF MECH. RM)

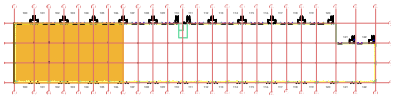

Key Plan

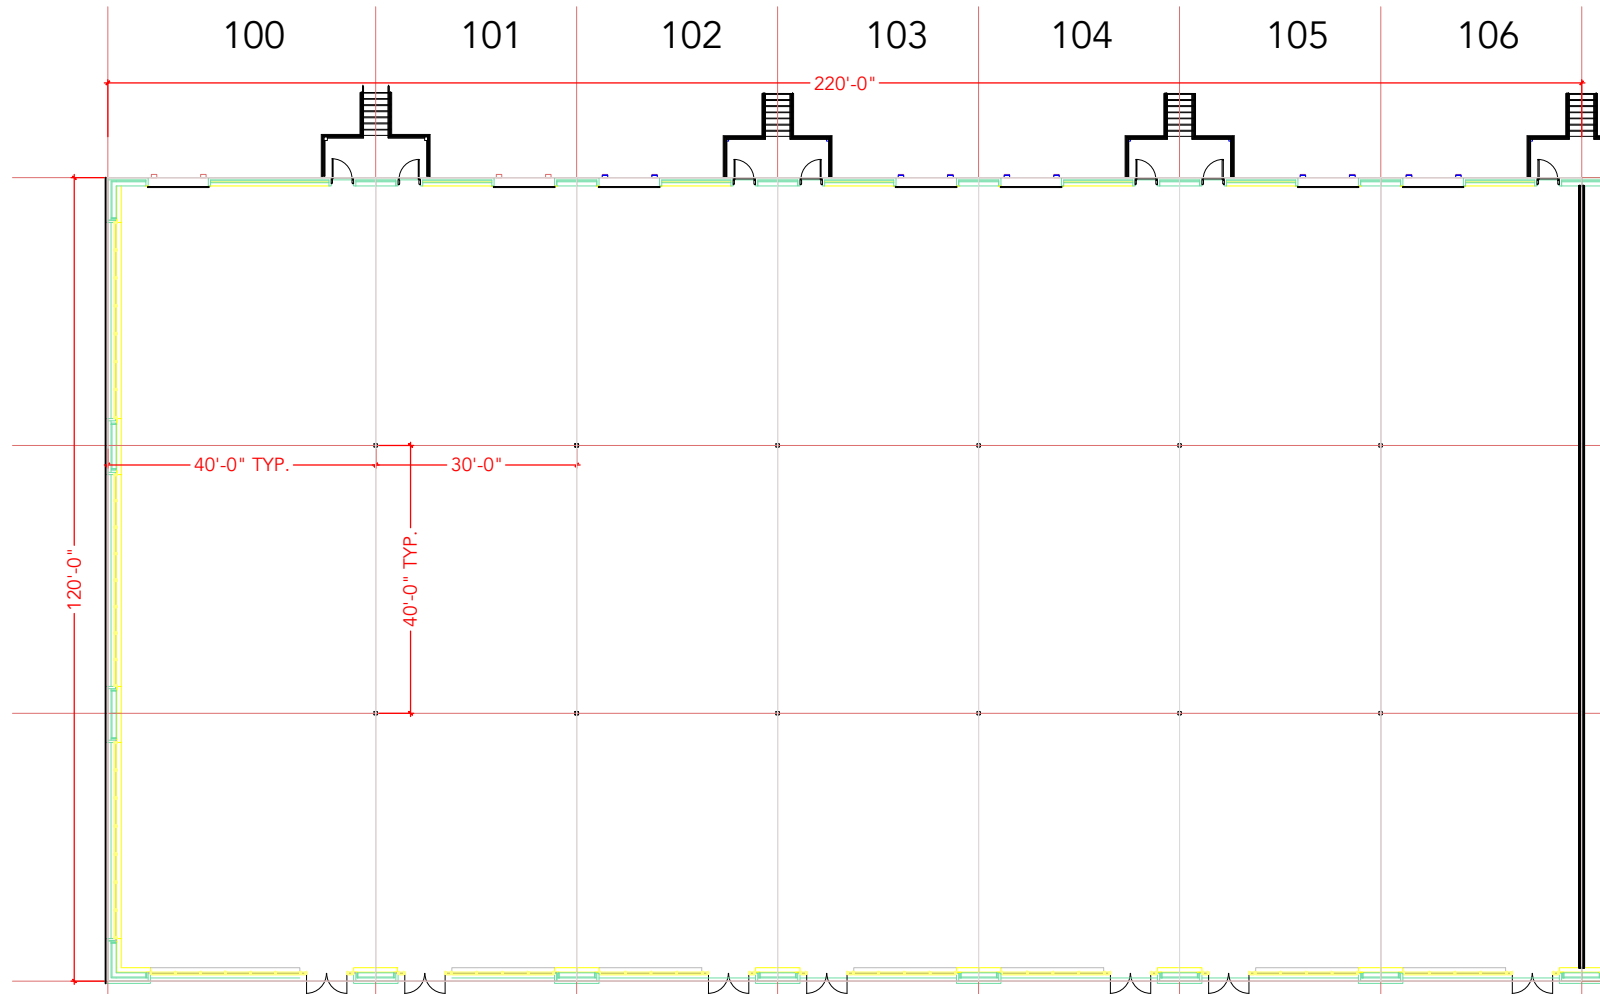

Floor Plan