



TOTAL SF AVAILABLE - 913 RSF (12%)

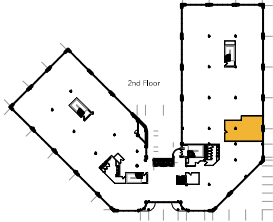

Key Plan

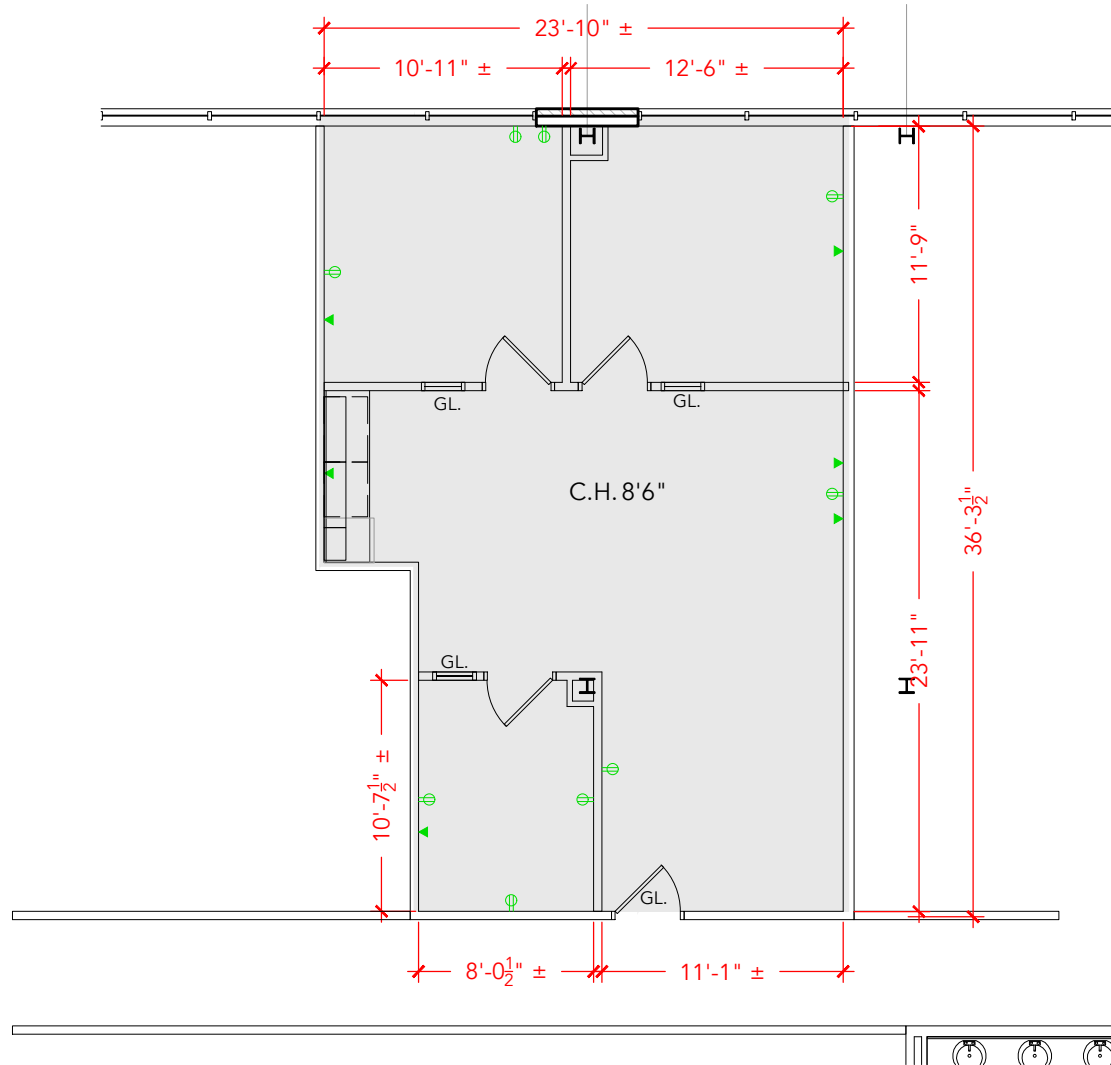

Floor Plan