



TOTAL SF AVAILABLE - 12,490 RSF (16%)

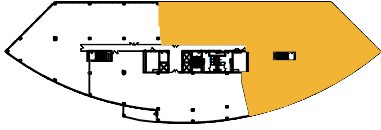

[Click to access 3D model](#)

Key Plan

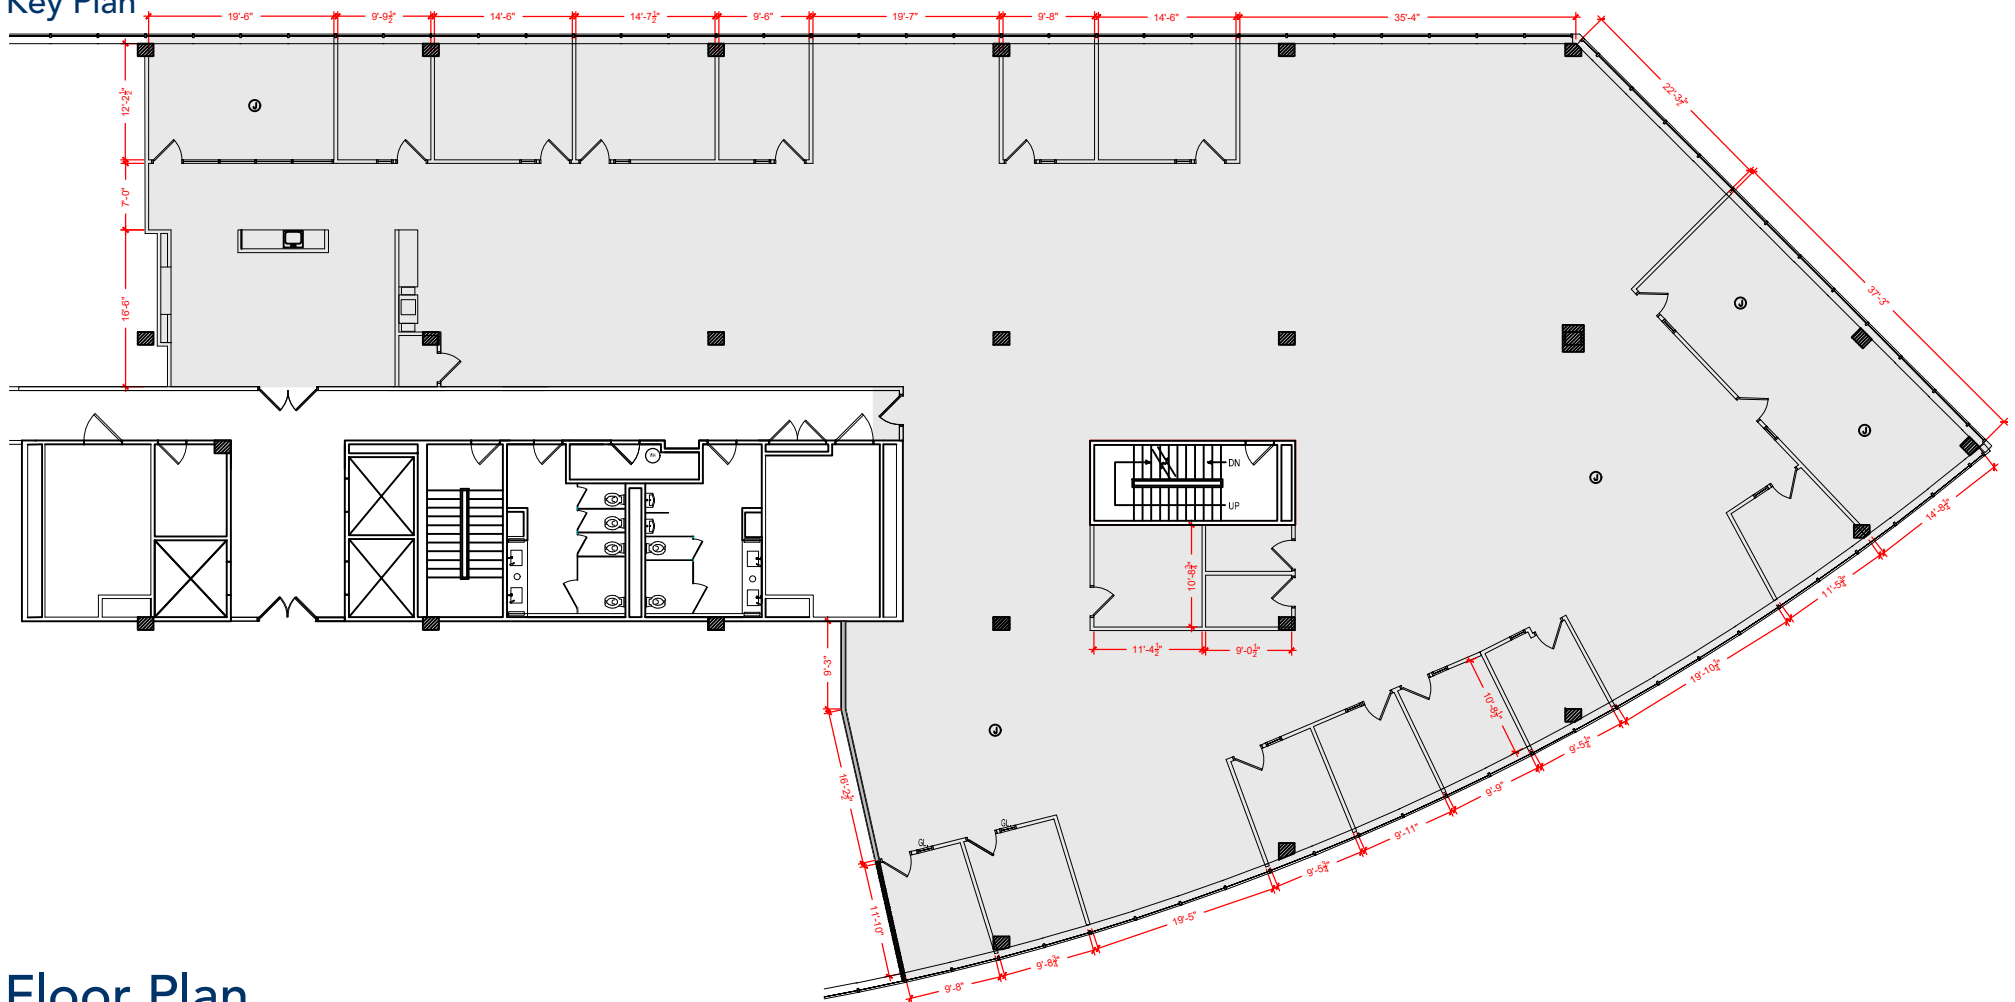

Floor Plan